


ROMPICHERLA-SAVALYAPURAM Jn.
6 QUAD, OFC & SIGNAL CABLE PATH

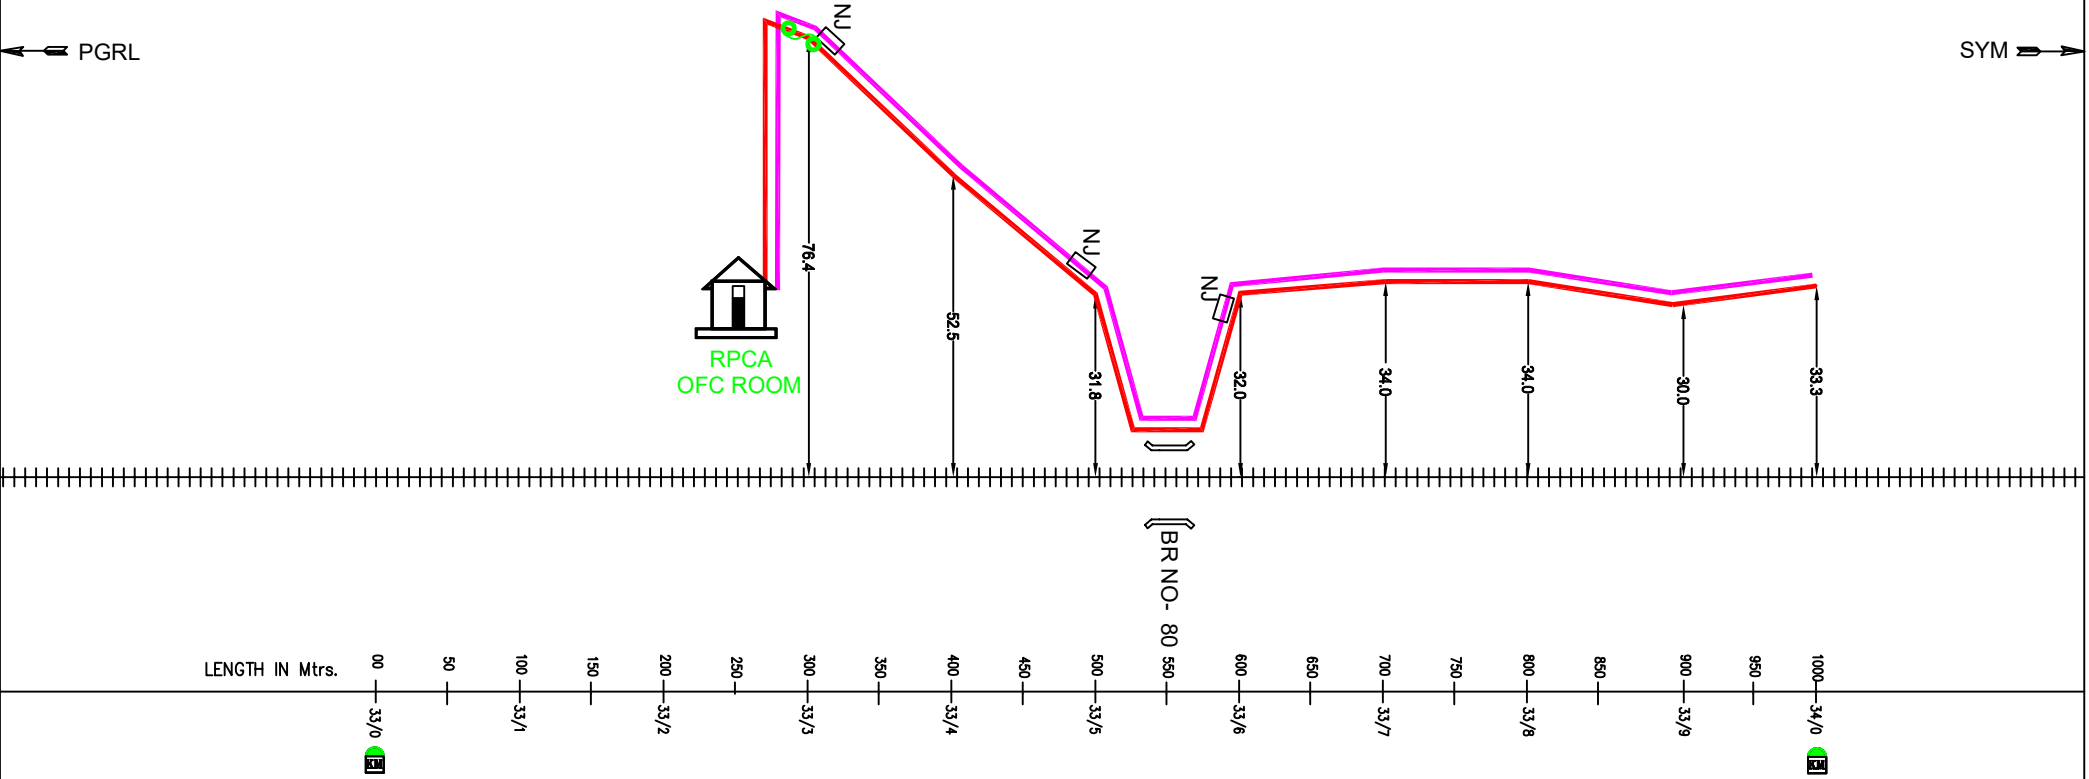


⦶	RAILWAY TRACK
—	6 QUAD CABLE
—	OFC CABLE
—	SIGNAL CABLE
□	NORMAL/ DERIVATION JOINT
⌋⌋	BRIDGE/CULVERT
⊙	EC POST
⌈⌋	L.C.GATE

ROMPICHERLA-SAVALYAPURAM Jn. 6 QUAD, OFC & SIGNAL CABLE PATH

← PGRL

SYM →

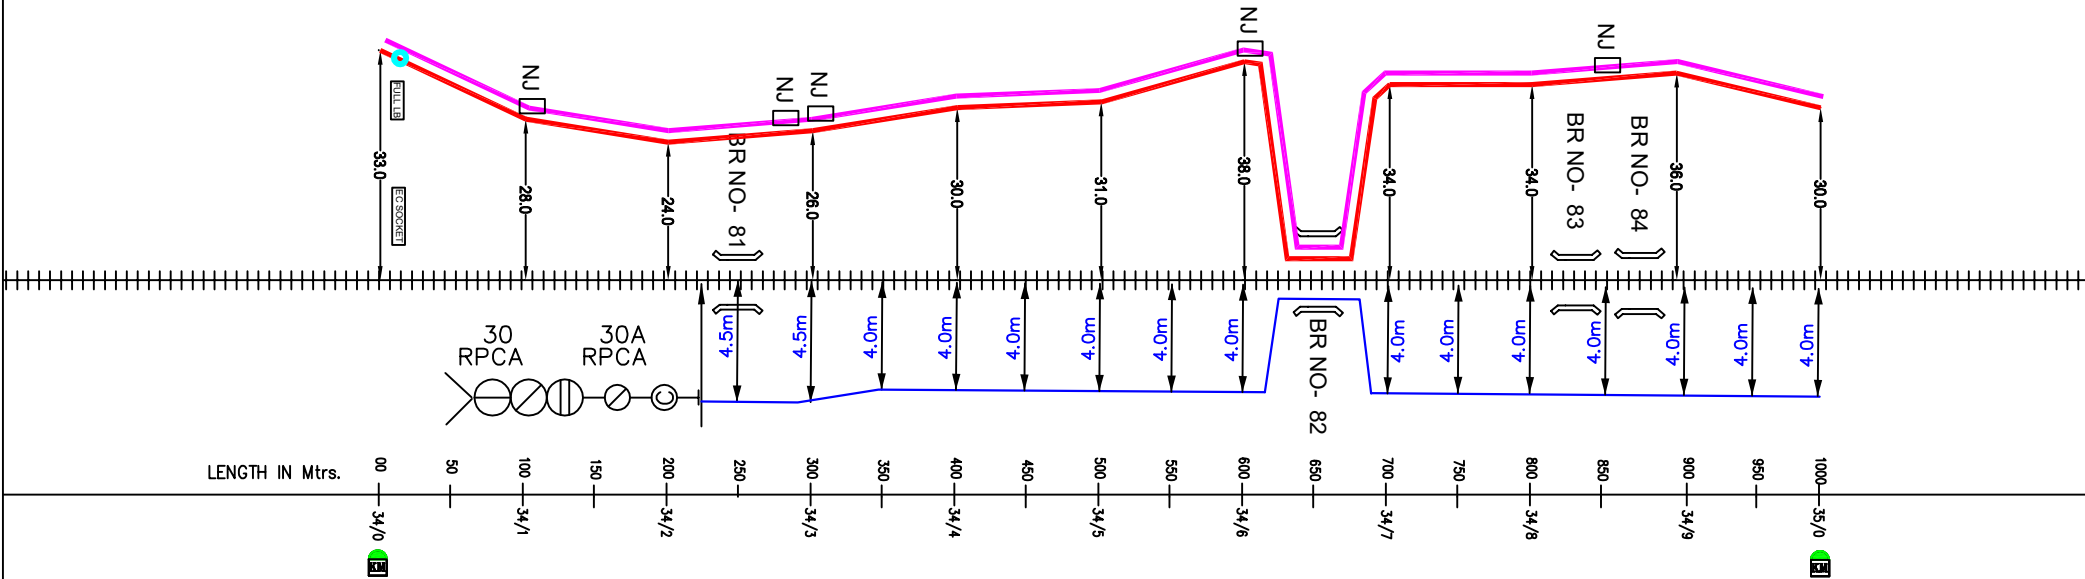


⦶	RAILWAY TRACK
—	6 QUAD CABLE
—	OFC CABLE
—	SIGNAL CABLE
□	NORMAL/ DERIVATION JOINT
⌋⌋	BRIDGE/CULVERT
⊙	EC POST
⌋⌋	L.C.GATE

ROMPICHERLA-SAVALYAPURAM Jn. 6 QUAD, OFC & SIGNAL CABLE PATH

← PGRL

SYM →

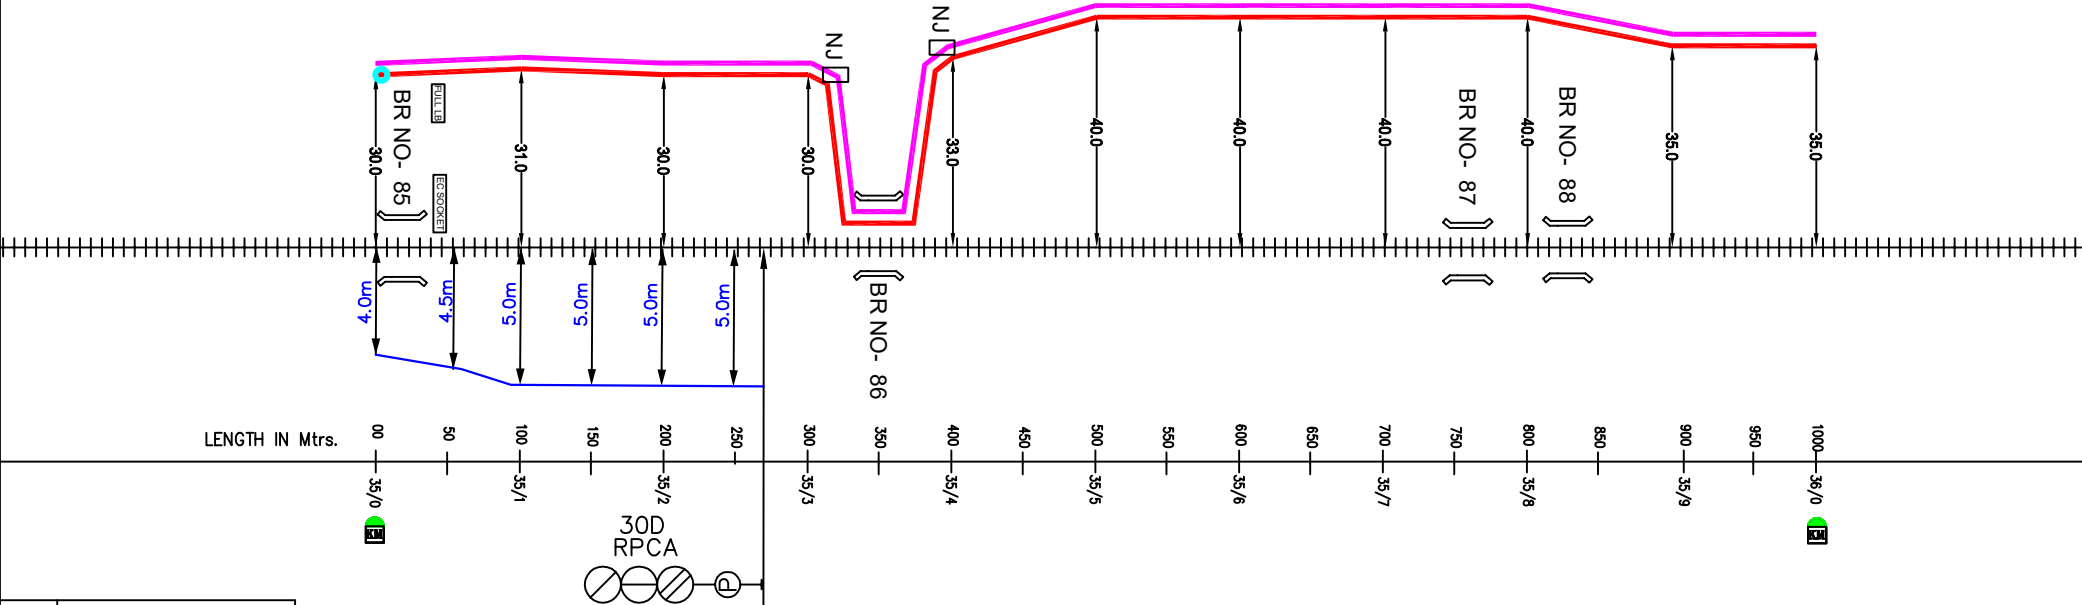

⦶	RAILWAY TRACK
—	6 QUAD CABLE
—	OFC CABLE
—	SIGNAL CABLE
□	NORMAL/ DERIVATION JOINT
⌋⌋	BRIDGE/CULVERT
⊙	EC POST
⌋⌋	L.C.GATE

SHEET 3 OF 18

RPCA - SYM SECTION

ROMPICHERLA-SAVALYAPURAM Jn. 6 QUAD, OFC & SIGNAL CABLE PATH



Symbol	Description
++	RAILWAY TRACK
— (Red)	6 QUAD CABLE
— (Blue)	OFC CABLE
— (Green)	SIGNAL CABLE
□	NORMAL/DERIVATION JOINT
≡	BRIDGE/CULVERT
⊕	EC POST
⊥	L.C.GATE


SHEET 4 OF 18

RPCA - SYM SECTION

ROMPICHERLA-SAVALYAPURAM Jn. 6 QUAD, OFC & SIGNAL CABLE PATH

← PGRL

SYM →

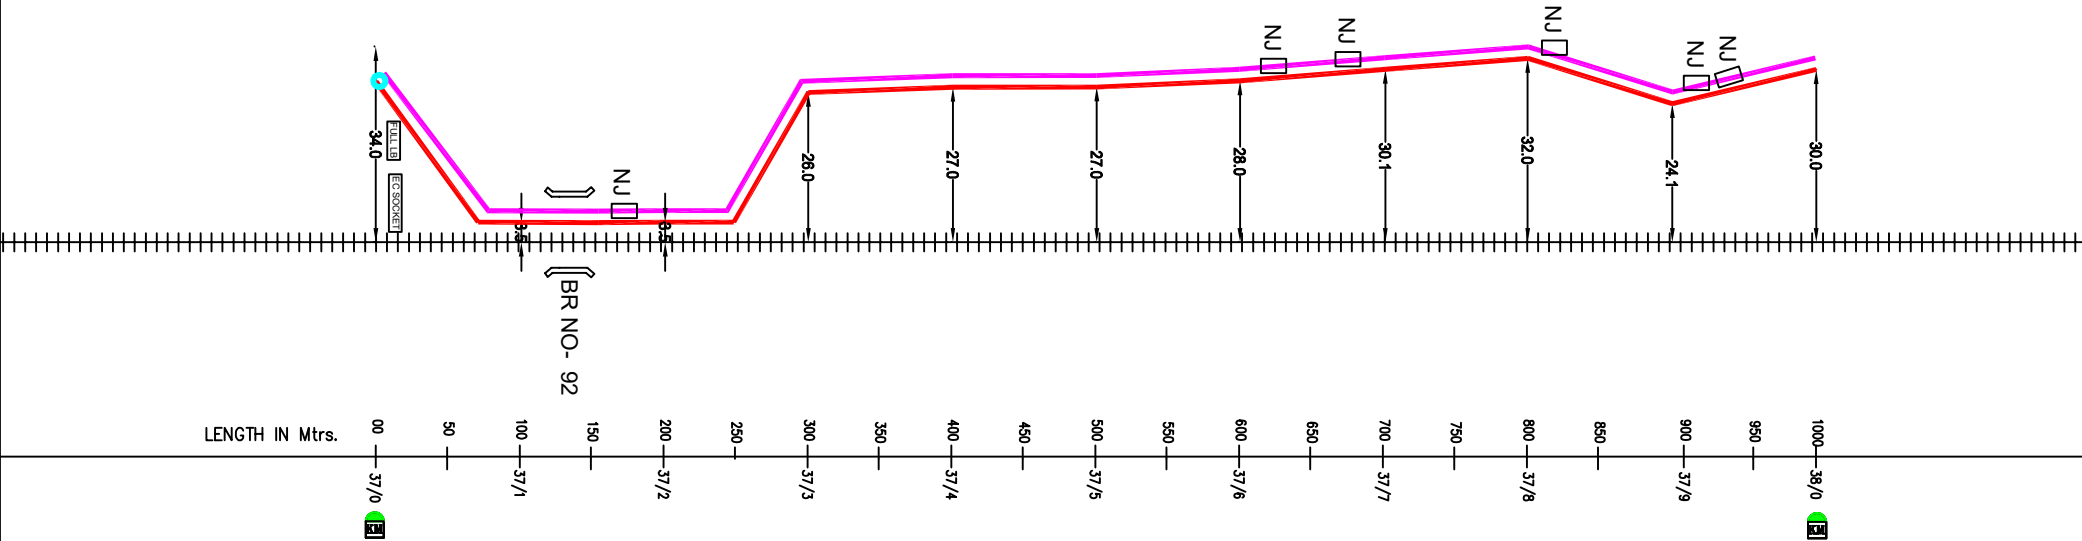


⦶	RAILWAY TRACK
—	6 QUAD CABLE
—	OFC CABLE
—	SIGNAL CABLE
□	NORMAL/ DERIVATION JOINT
⌋⌋	BRIDGE/CULVERT
⊙	EC POST
⌈⌋	L.C.GATE

ROMPICHERLA-SAVALYAPURAM Jn.
6 QUAD, OFC & SIGNAL CABLE PATH


← PGRL

SYM →

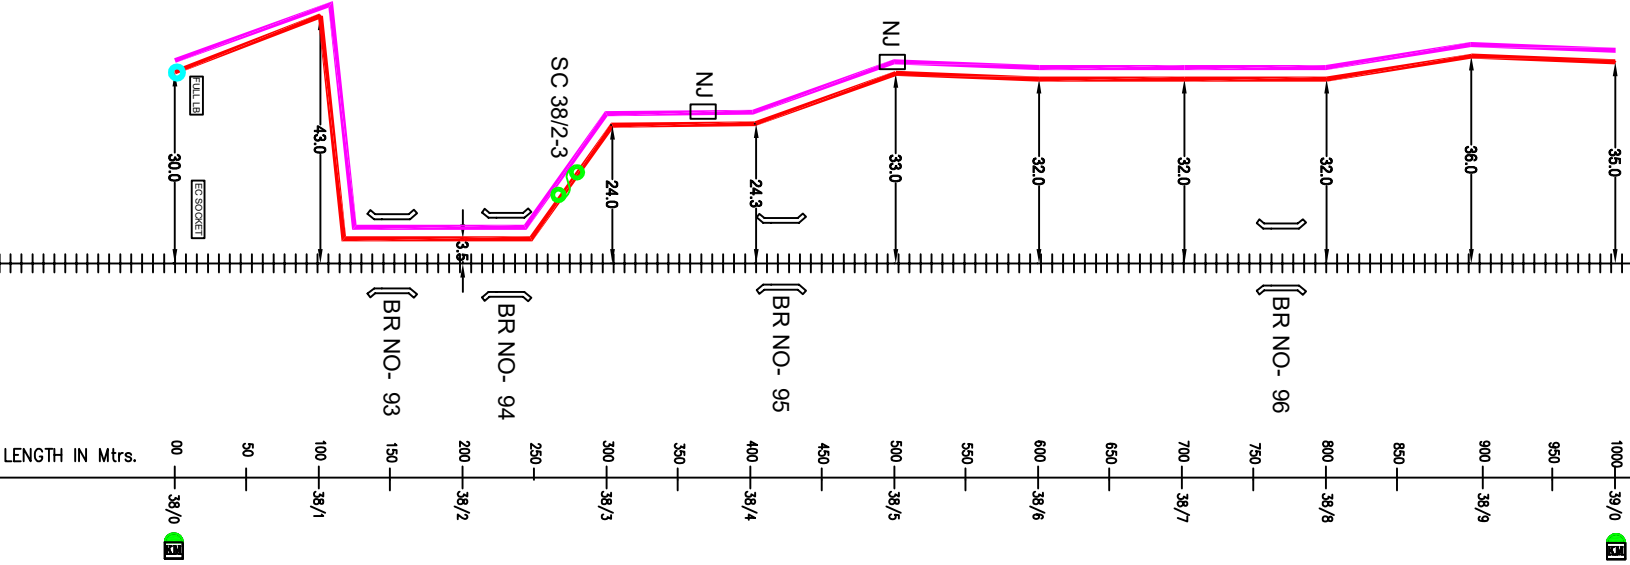

⦶	RAILWAY TRACK
—	6 QUAD CABLE
—	OFC CABLE
—	SIGNAL CABLE
□	NORMAL/ DERIVATION JOINT
⌋⌋	BRIDGE/CULVERT
⊙	EC POST
⌋⌋	L.C.GATE

ROMPICHERLA-SAVALYAPURAM Jn. 6 QUAD, OFC & SIGNAL CABLE PATH

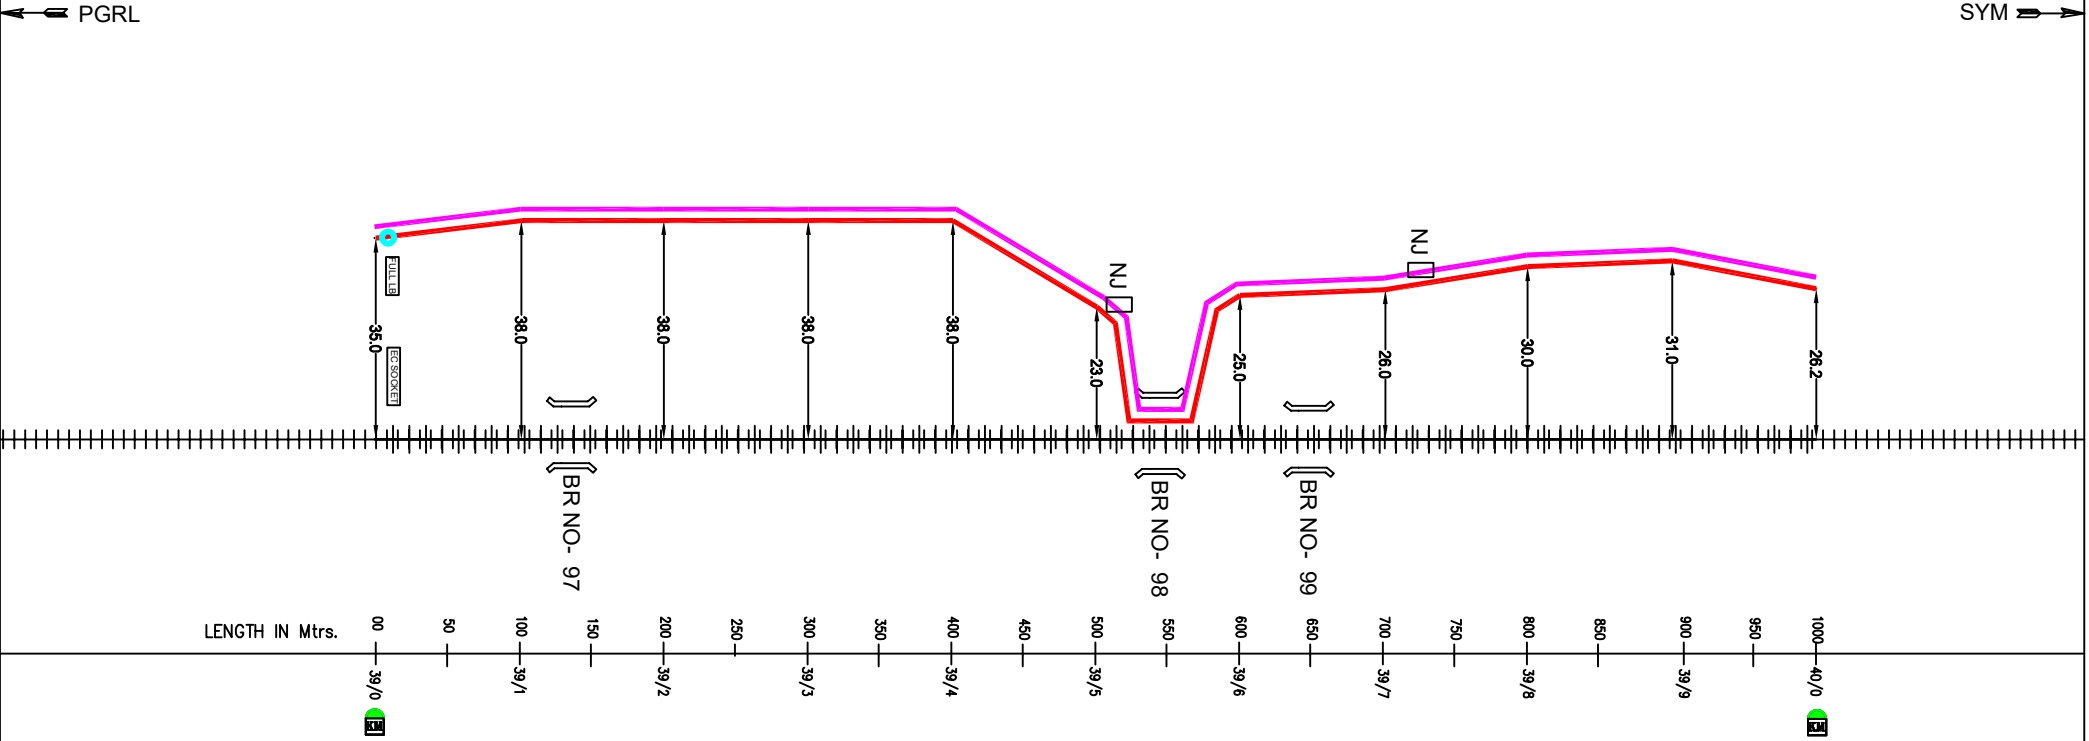


⦶	RAILWAY TRACK
—	6 QUAD CABLE
—	OFC CABLE
—	SIGNAL CABLE
□	NORMAL/ DERIVATION JOINT
⌋⌋	BRIDGE/CULVERT
⊙	EC POST
⌋⌋	L.C.GATE

ROMPICHERLA-SAVALYAPURAM Jn.
6 QUAD, OFC & SIGNAL CABLE PATH

← PGRL

SYM →

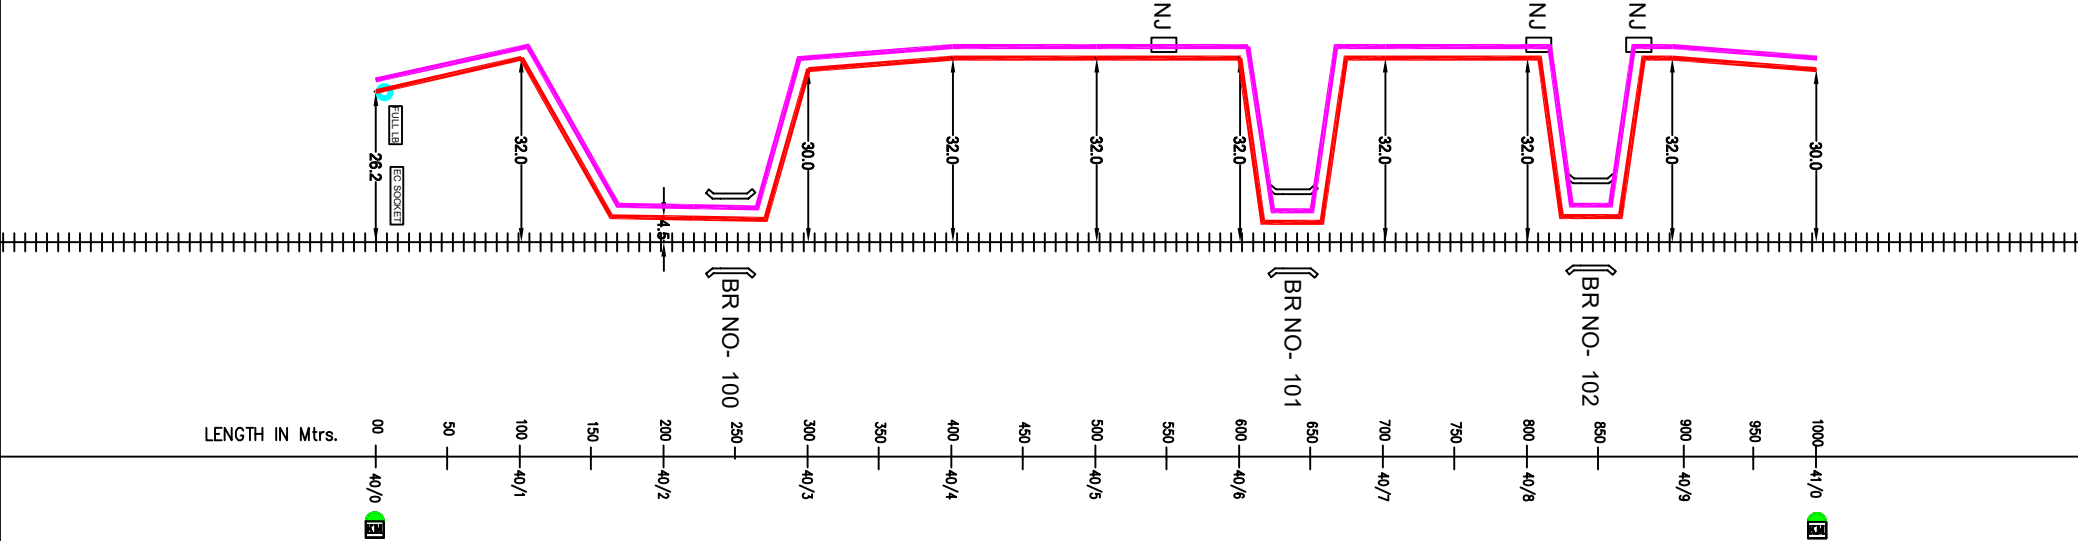

⦶	RAILWAY TRACK
—	6 QUAD CABLE
—	OFC CABLE
—	SIGNAL CABLE
□	NORMAL/ DERIVATION JOINT
⌋⌋	BRIDGE/CULVERT
⊙	EC POST
⌈⌋	L.C.GATE


SHEET 8 OF 18

RPCA - SYM SECTION

ROMPICHERLA-SAVALYAPURAM Jn. 6 QUAD, OFC & SIGNAL CABLE PATH

← PGRL

SYM →

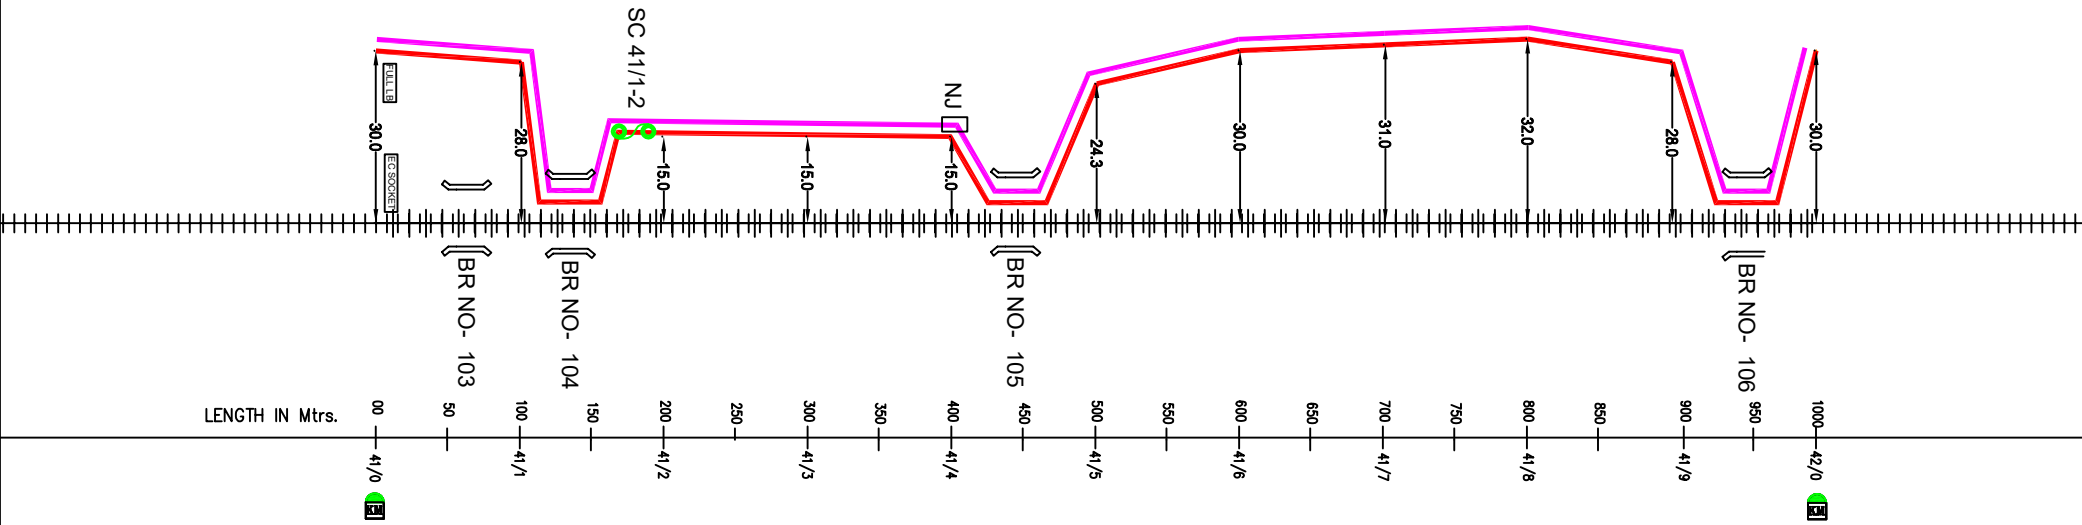

⦶	RAILWAY TRACK
—	6 QUAD CABLE
—	OFC CABLE
—	SIGNAL CABLE
□	NORMAL/ DERIVATION JOINT
⌋⌋	BRIDGE/CULVERT
⊙	EC POST
⌈⌋	L.C.GATE


SHEET 9 OF 18

RPCA - SYM SECTION

ROMPICHERLA-SAVALYAPURAM Jn.
6 QUAD, OFC & SIGNAL CABLE PATH


← PGRL

SYM →

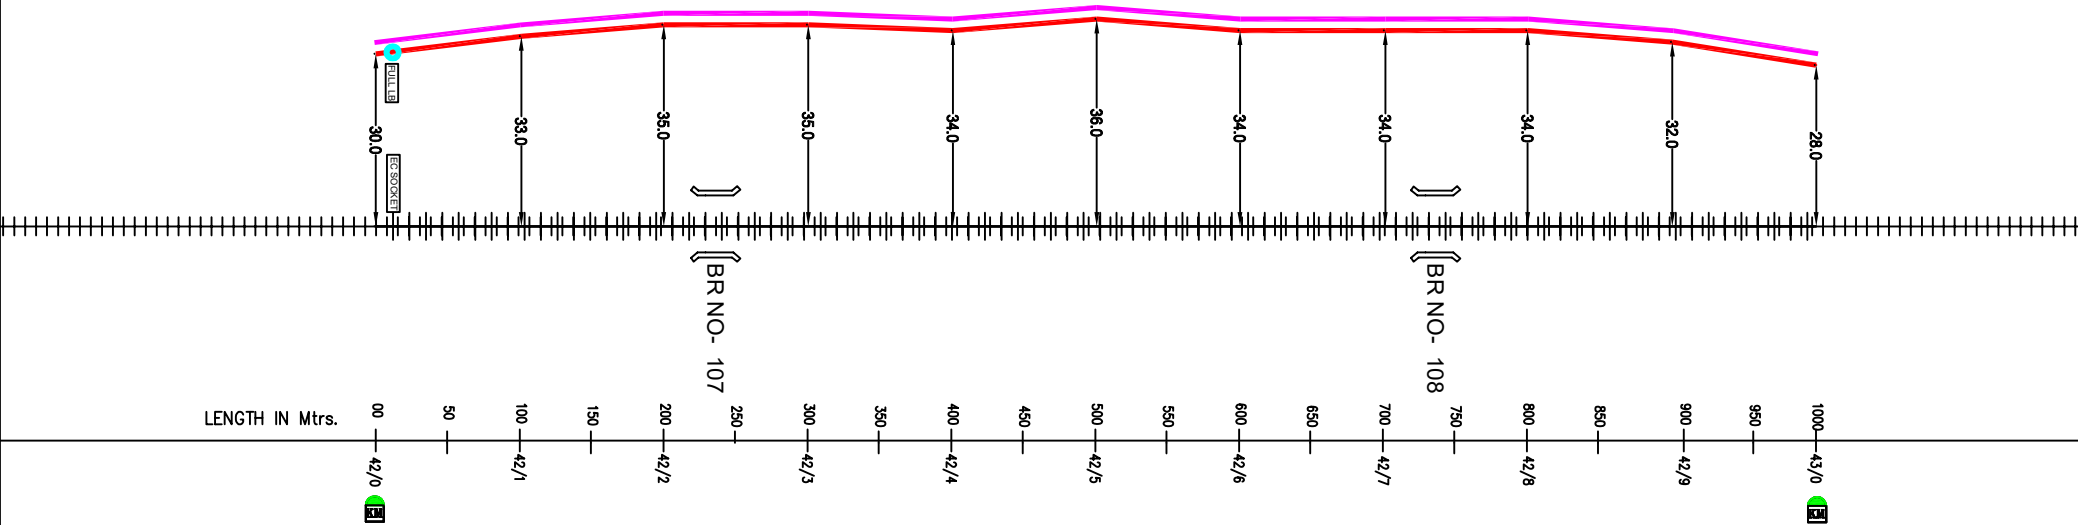

⦶	RAILWAY TRACK
—	6 QUAD CABLE
—	OFC CABLE
—	SIGNAL CABLE
□	NORMAL/ DERIVATION JOINT
⌋⌋	BRIDGE/CULVERT
⊙	EC POST
⌈⌋	L.C.GATE

ROMPICHERLA-SAVALYAPURAM Jn. 6 QUAD, OFC & SIGNAL CABLE PATH

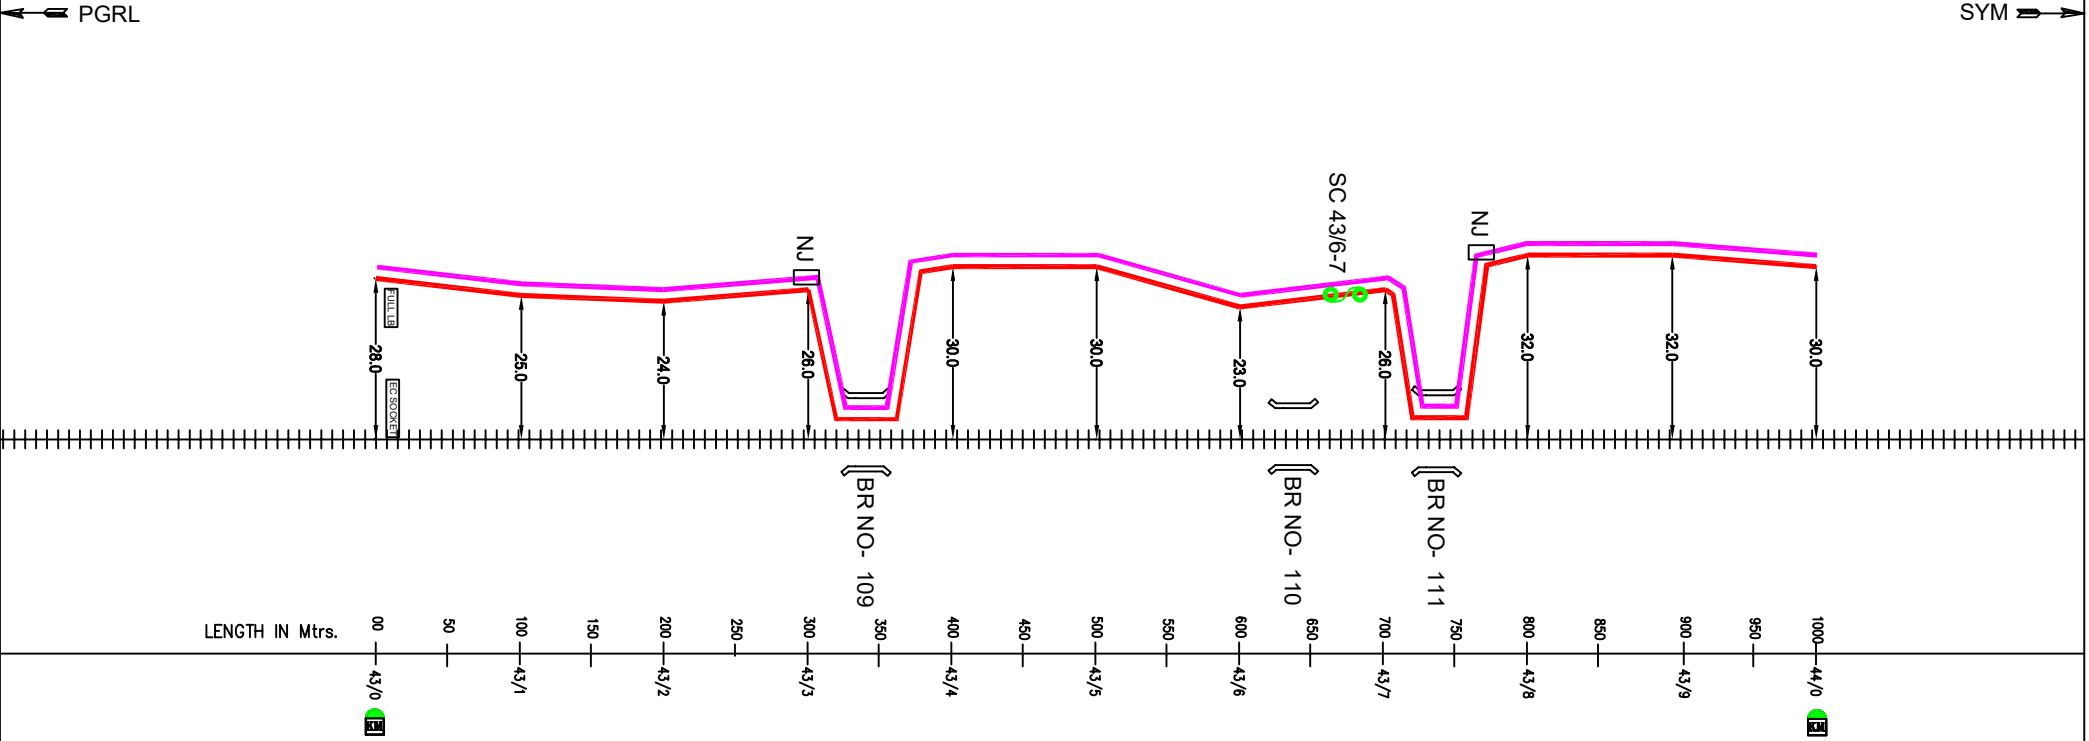


⦶	RAILWAY TRACK
—	6 QUAD CABLE
—	OFC CABLE
—	SIGNAL CABLE
□	NORMAL/ DERIVATION JOINT
⌋⌋	BRIDGE/CULVERT
⊙	EC POST
⌋⌋	L.C.GATE

ROMPICHERLA-SAVALYAPURAM Jn. 6 QUAD, OFC & SIGNAL CABLE PATH

← PGRL

SYM →

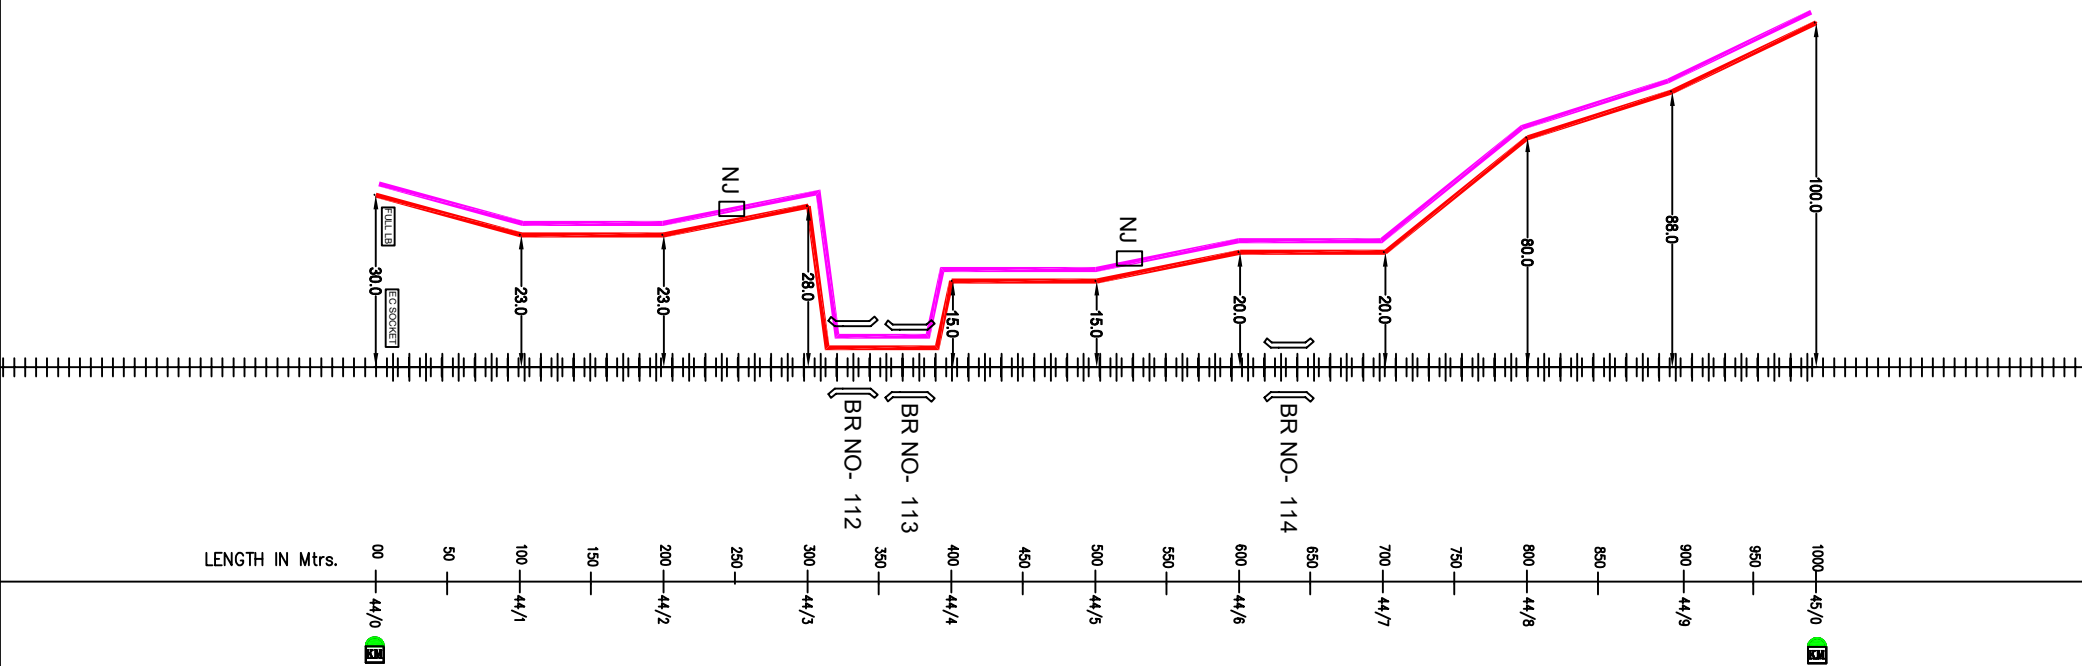


⦶	RAILWAY TRACK
—	6 QUAD CABLE
—	OFC CABLE
—	SIGNAL CABLE
□	NORMAL/ DERIVATION JOINT
⌋⌋	BRIDGE/CULVERT
⊙	EC POST
⌈⌋	L.C.GATE

SHEET 12 OF 18

RPCA - SYM SECTION

ROMPICHERLA-SAVALYAPURAM Jn. 6 QUAD, OFC & SIGNAL CABLE PATH

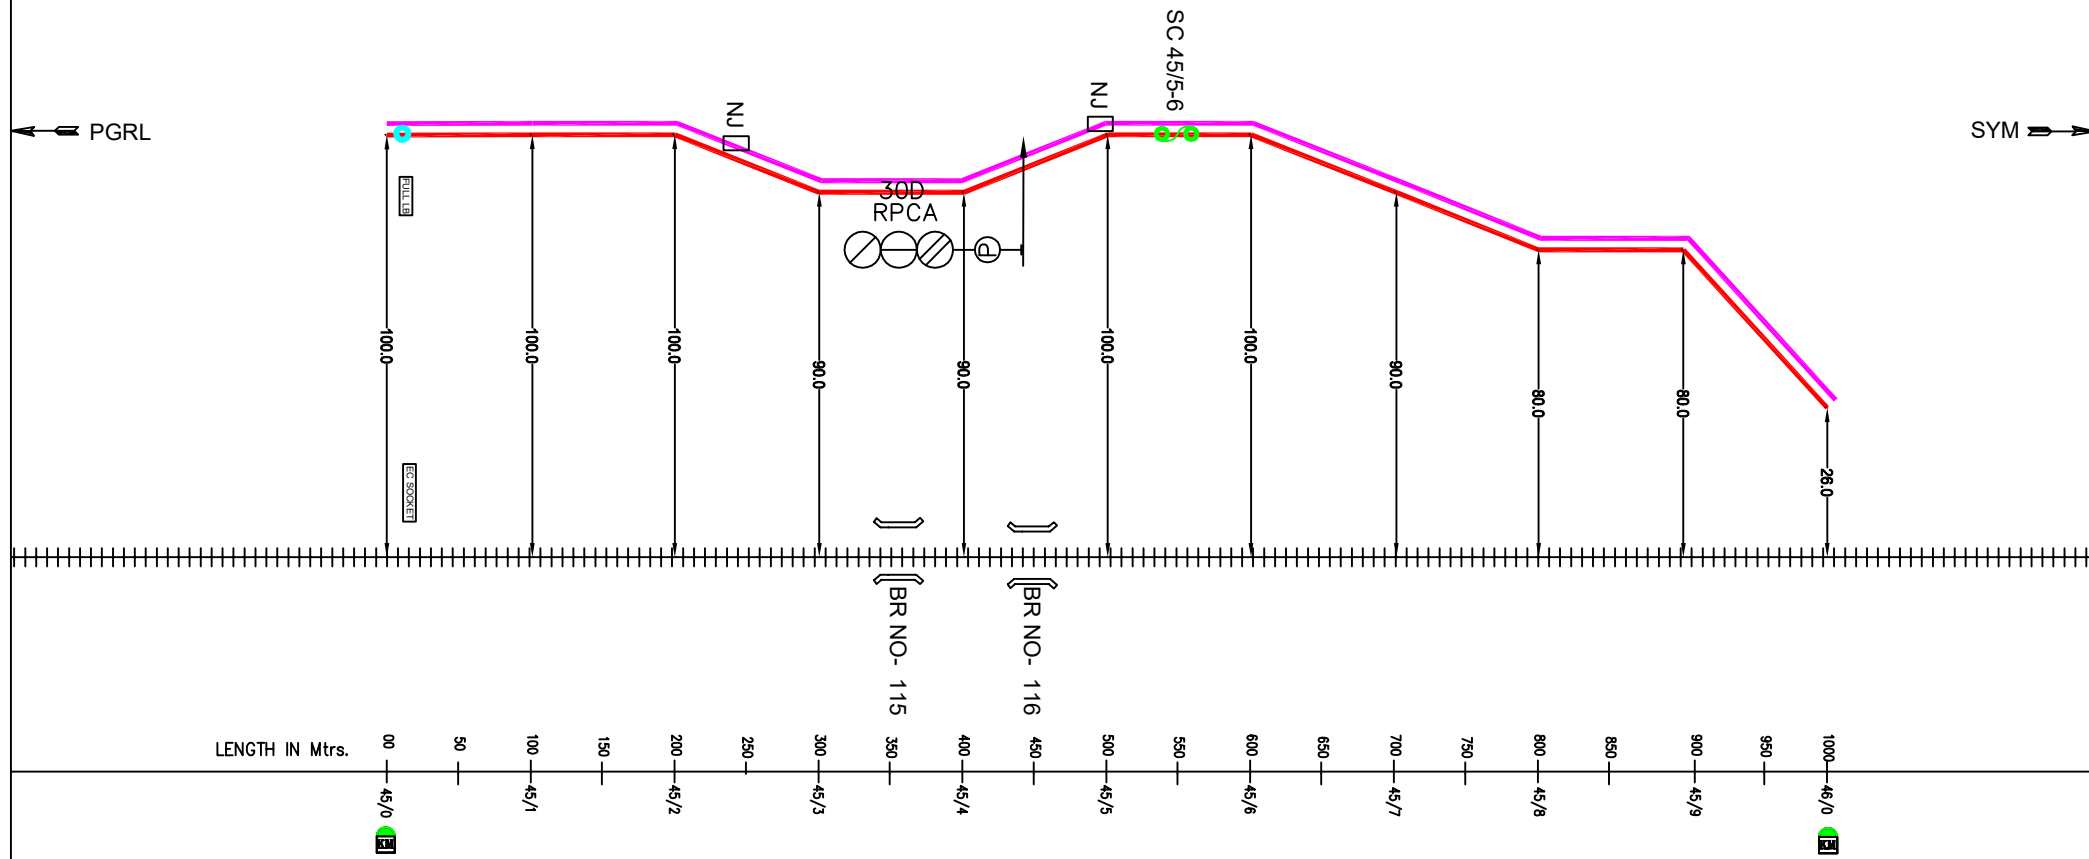


⦶	RAILWAY TRACK
—	6 QUAD CABLE
—	OFC CABLE
—	SIGNAL CABLE
□	NORMAL/ DERIVATION JOINT
⌋⌋	BRIDGE/CULVERT
⊙	EC POST
⌈⌋	L.C.GATE

ROMPICHERLA-SAVALYAPURAM Jn. 6 QUAD, OFC & SIGNAL CABLE PATH

← PGRL

SYM →

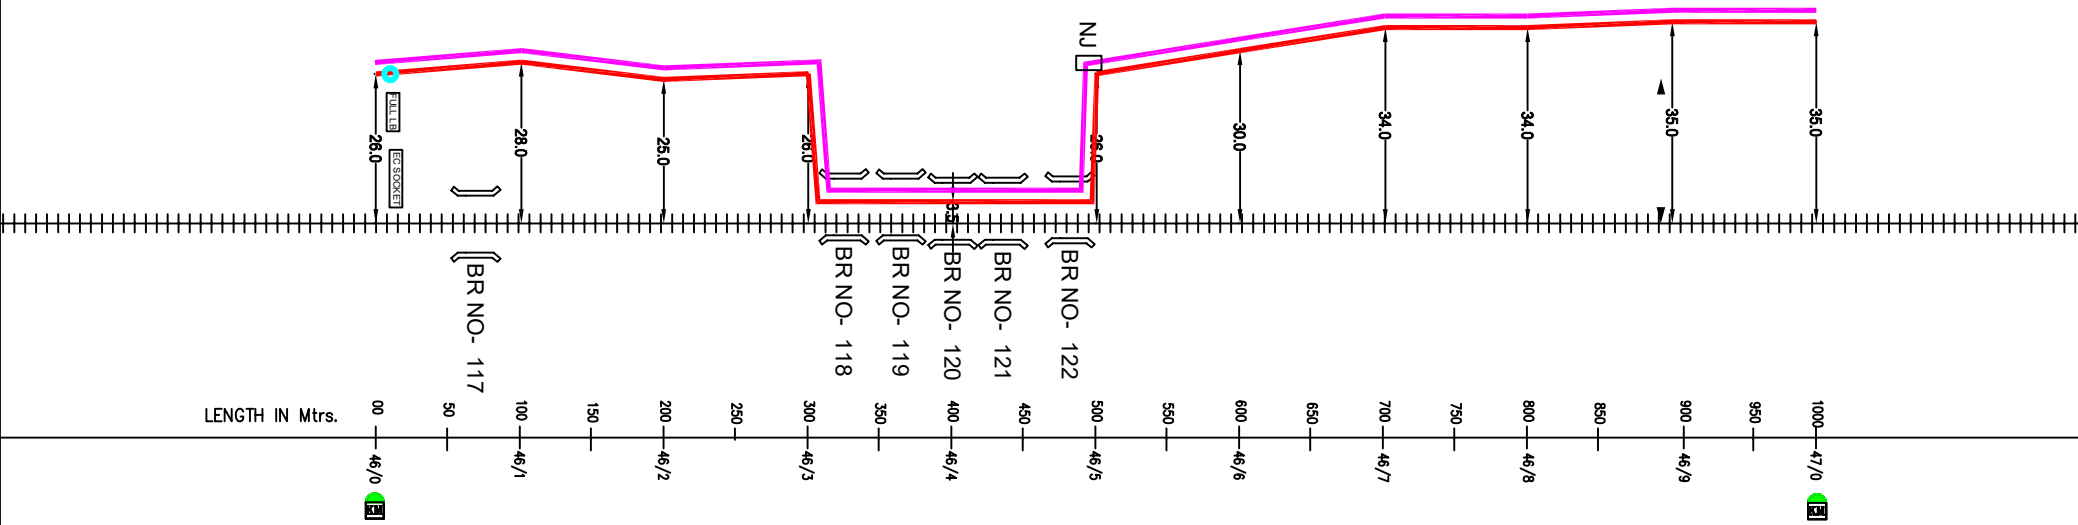


⦶	RAILWAY TRACK
—	6 QUAD CABLE
—	OFC CABLE
—	SIGNAL CABLE
□	NORMAL/ DERIVATION JOINT
⌋	BRIDGE/CULVERT
⊙	EC POST
⌋	L.C.GATE

ROMPICHERLA-SAVALYAPURAM Jn.
6 QUAD, OFC & SIGNAL CABLE PATH

← PGRL

SYM →

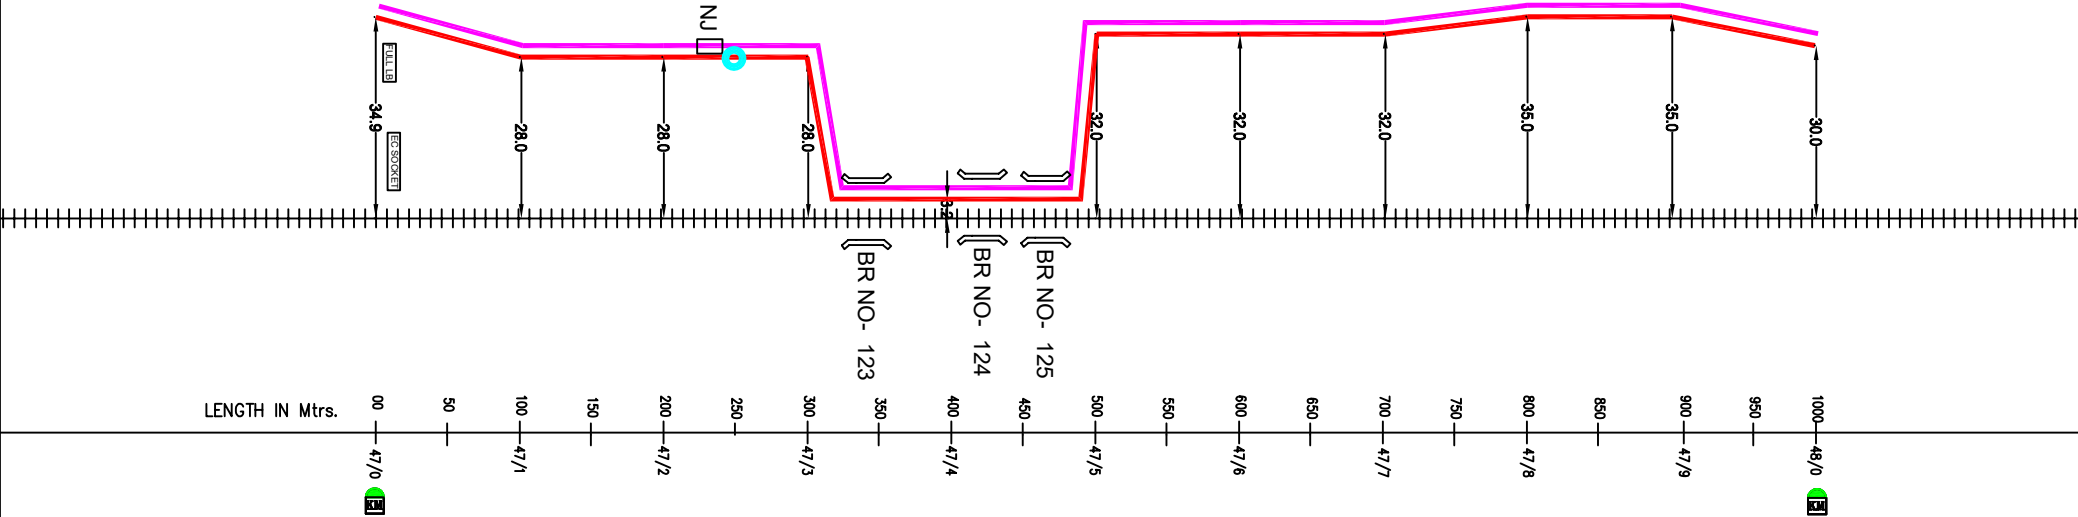


⦶	RAILWAY TRACK
—	6 QUAD CABLE
—	OFC CABLE
—	SIGNAL CABLE
□	NORMAL/ DERIVATION JOINT
⌋⌋	BRIDGE/CULVERT
⊙	EC POST
⌈⌋	L.C.GATE

SHEET 15 OF 18

RPCA - SYM SECTION

SYM

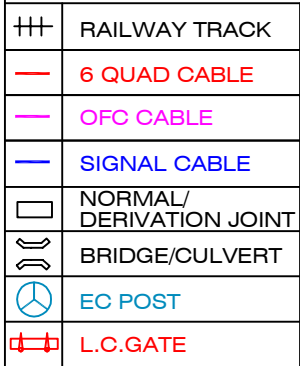


RPCA - SYM SECTION

ROMPICHERLA-SAVALYAPURAM Jn. 6 QUAD, OFC & SIGNAL CABLE PATH

← PGRL

SYM →

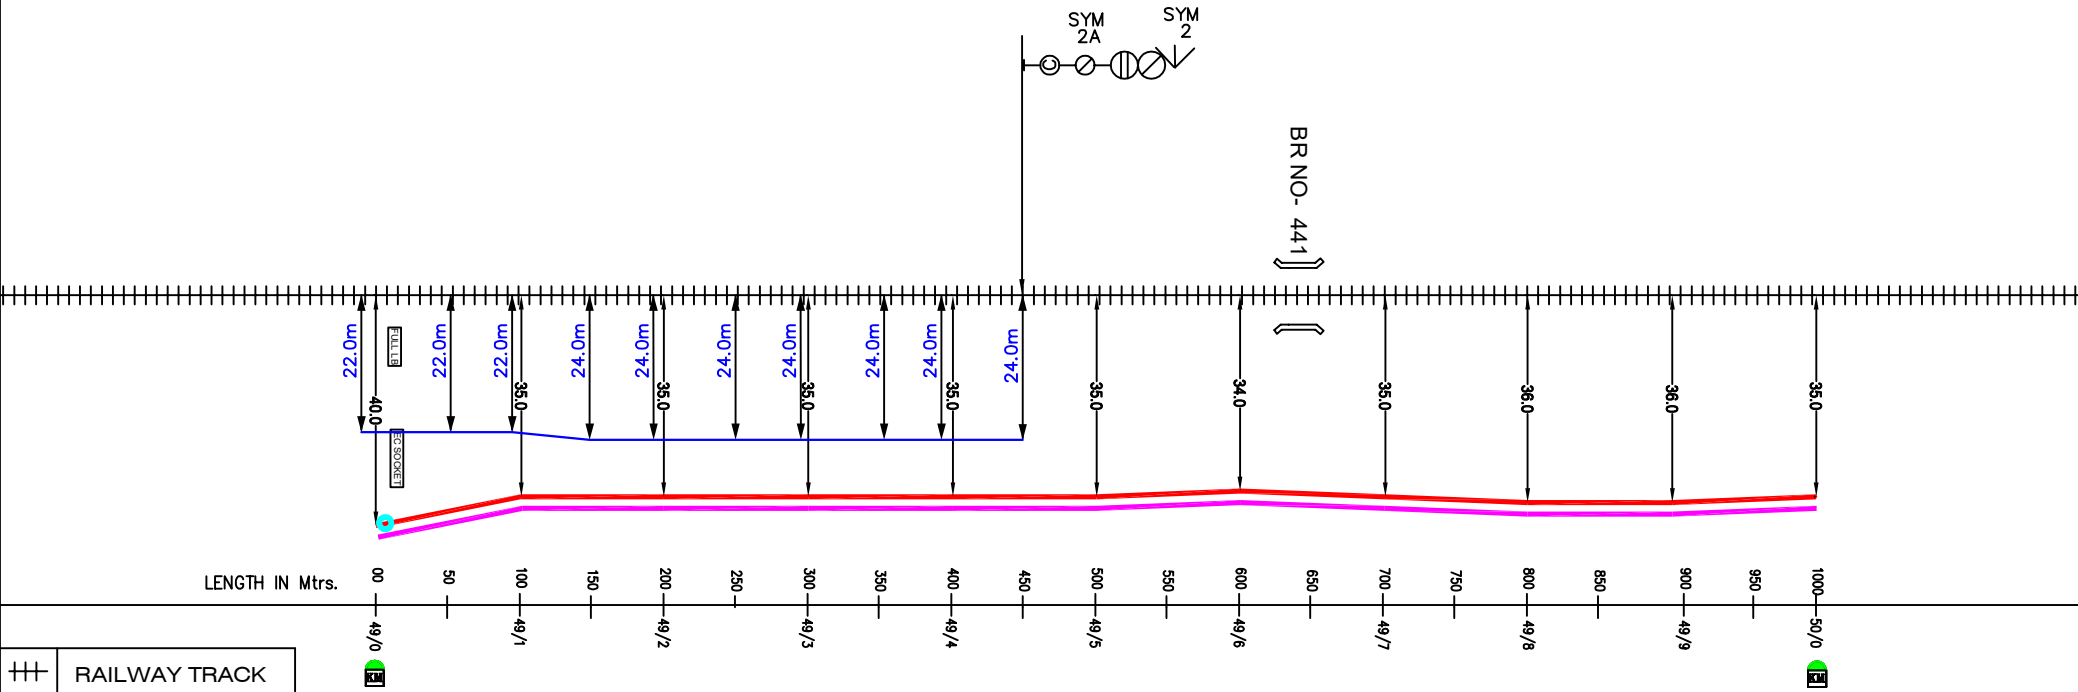

⦶	RAILWAY TRACK
—	6 QUAD CABLE
—	OFC CABLE
—	SIGNAL CABLE
□	NORMAL/ DERIVATION JOINT
⌋⌋	BRIDGE/CULVERT
⊙	EC POST
⌋⌋	L.C.GATE


SHEET 17 OF 18

RPCA - SYM SECTION

ROMPICHERLA-SAVALYAPURAM Jn.
6 QUAD, OFC & SIGNAL CABLE PATH

← PGRL

SYM →

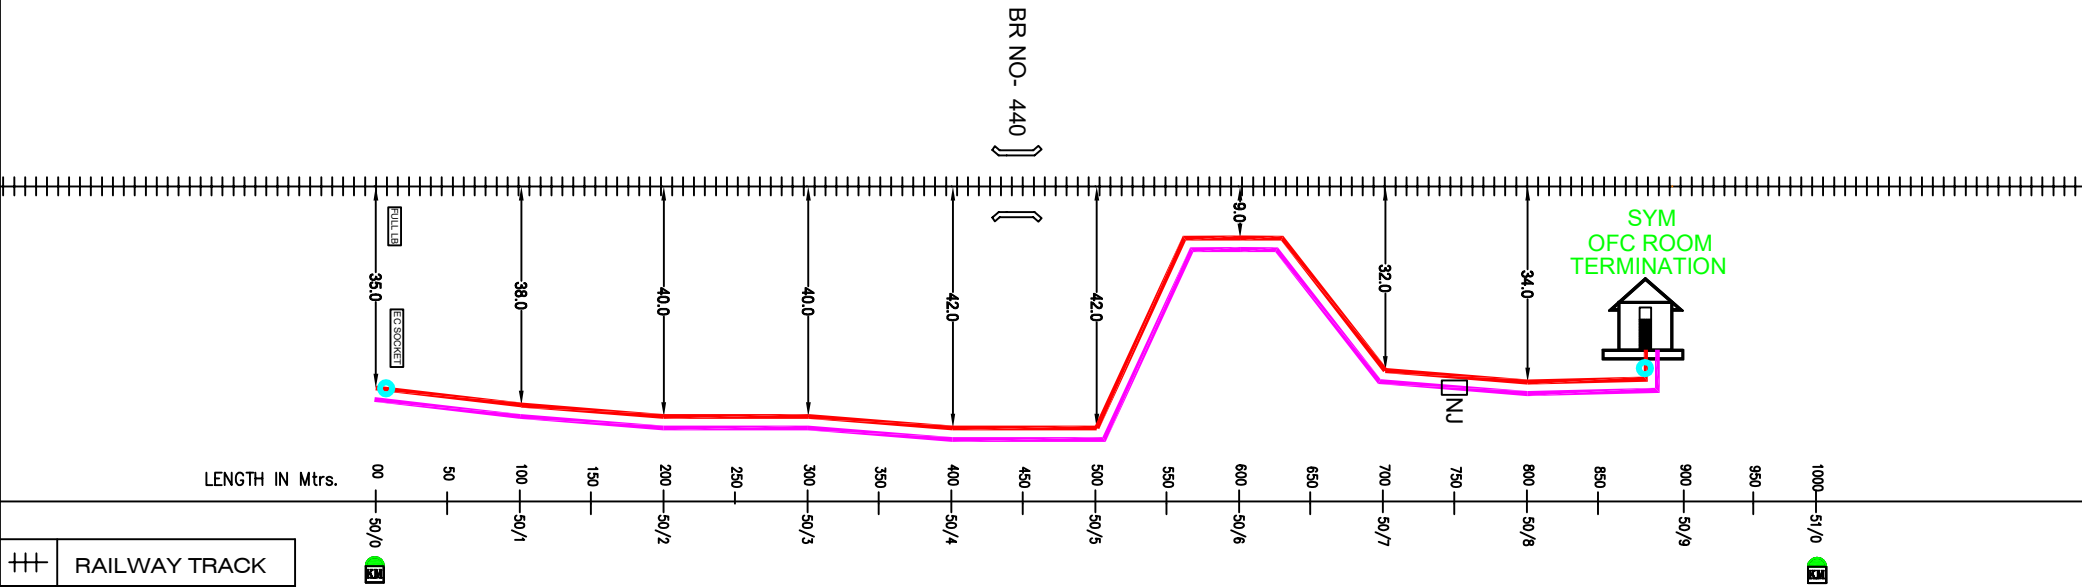

⦶	RAILWAY TRACK
—	6 QUAD CABLE
—	OFC CABLE
—	SIGNAL CABLE
□	NORMAL/ DERIVATION JOINT
⌋⌋	BRIDGE/CULVERT
⊙	EC POST
⌈⌋	L.C.GATE

SHEET 18 OF 18

—	(M.NAGESWARA RAO NAIK) SSE/D	AGM/RCIL	(M.SUBRAMANYAM) SSE/S/VKN	(G.VENKATESWARLU) SSE/T/VKN	(D.SARATH BABU) ADSTE/GNT	(B.LAKSHMAN) Sr.DSTE/GNT
ALT No.						

RPCA - SYM SECTION