


SANTHAMAGULUR-SAVALYAPURAM Jn.
6 QUAD, OFC & SIGNAL CABLE PATH

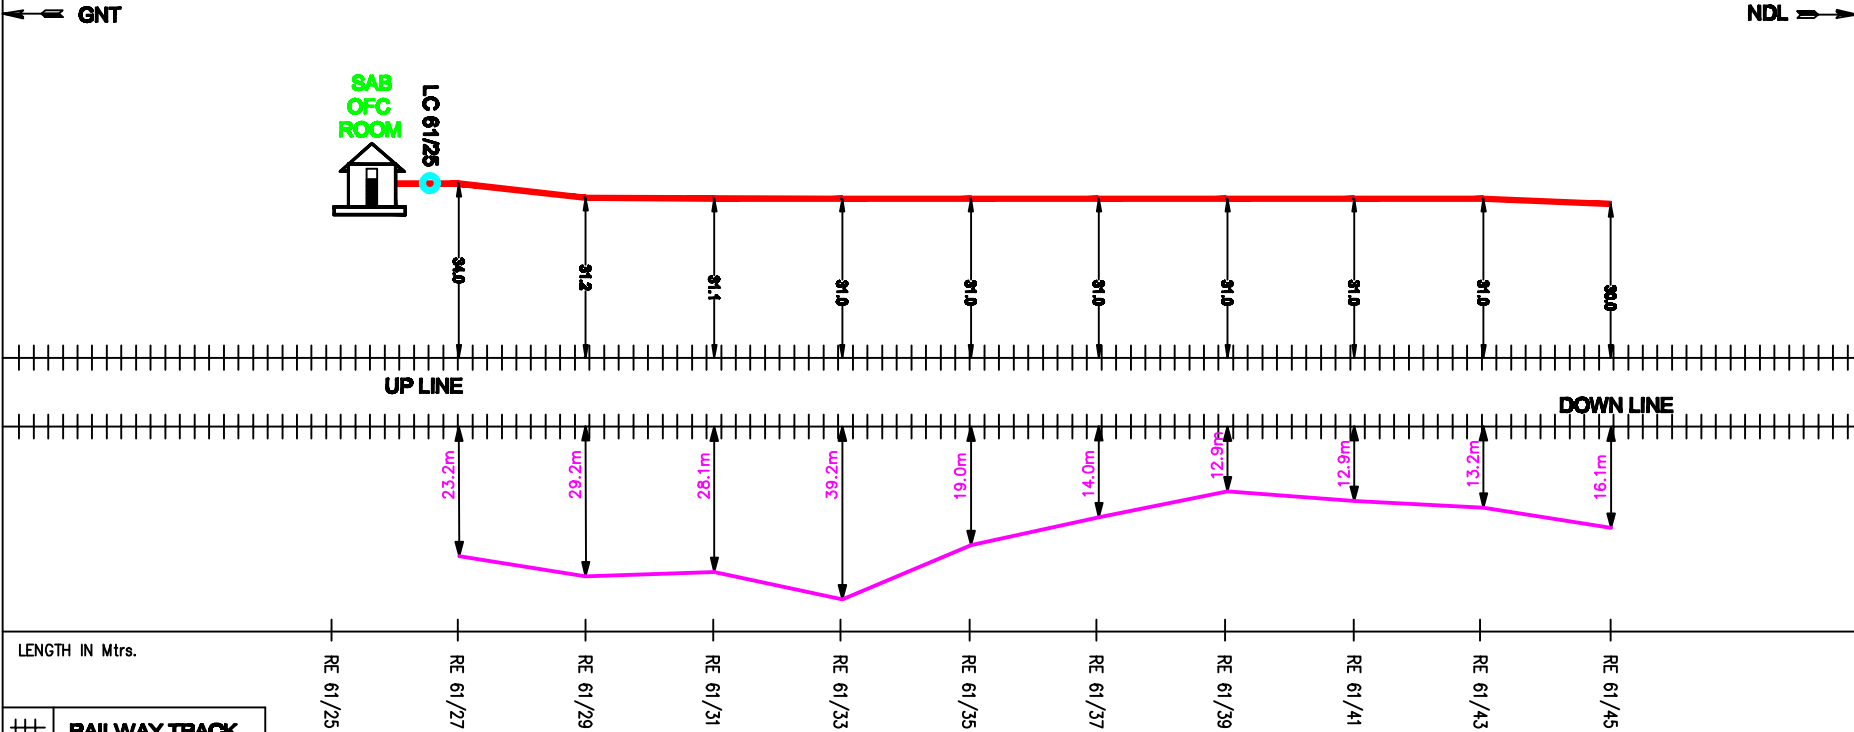

LENGTH IN Mtrs.

++	RAILWAY TRACK
—	6Q & OFC CABLE
—	FCIL OFC CABLE
—	SIGNAL CABLE
□	NORMAL/DERIVATION JOINT
⌋⌋	BRIDGE/OUTVERT
⊕	EC POST
⌋⌋	L.O.GATE

SANTHAMAGULUR-SAVALYAPURAM Jn.

6 QUAD, OFC & SIGNAL CABLE PATH

GNT ← → NDL

BR NO. 447

LENGTH IN Mtrs.


Symbol	Description
++	RAILWAY TRACK
Red line	6Q & OFC CABLE
Magenta line	FCIL OFC CABLE
Blue line	SIGNAL CABLE
□	NORMAL/DERIVATION JOINT
⌋⌋	BRIDGE/CULVERT
⊕	EO POST
⌋⌋	L.O.GATE

02 SAB 02A SAB

SHEET 2 OF 12

SAB - SYM SECTION


SANTHAMAGULUR-SAVALYAPURAM Jn. **6 QUAD, OFC & SIGNAL CABLE PATH**

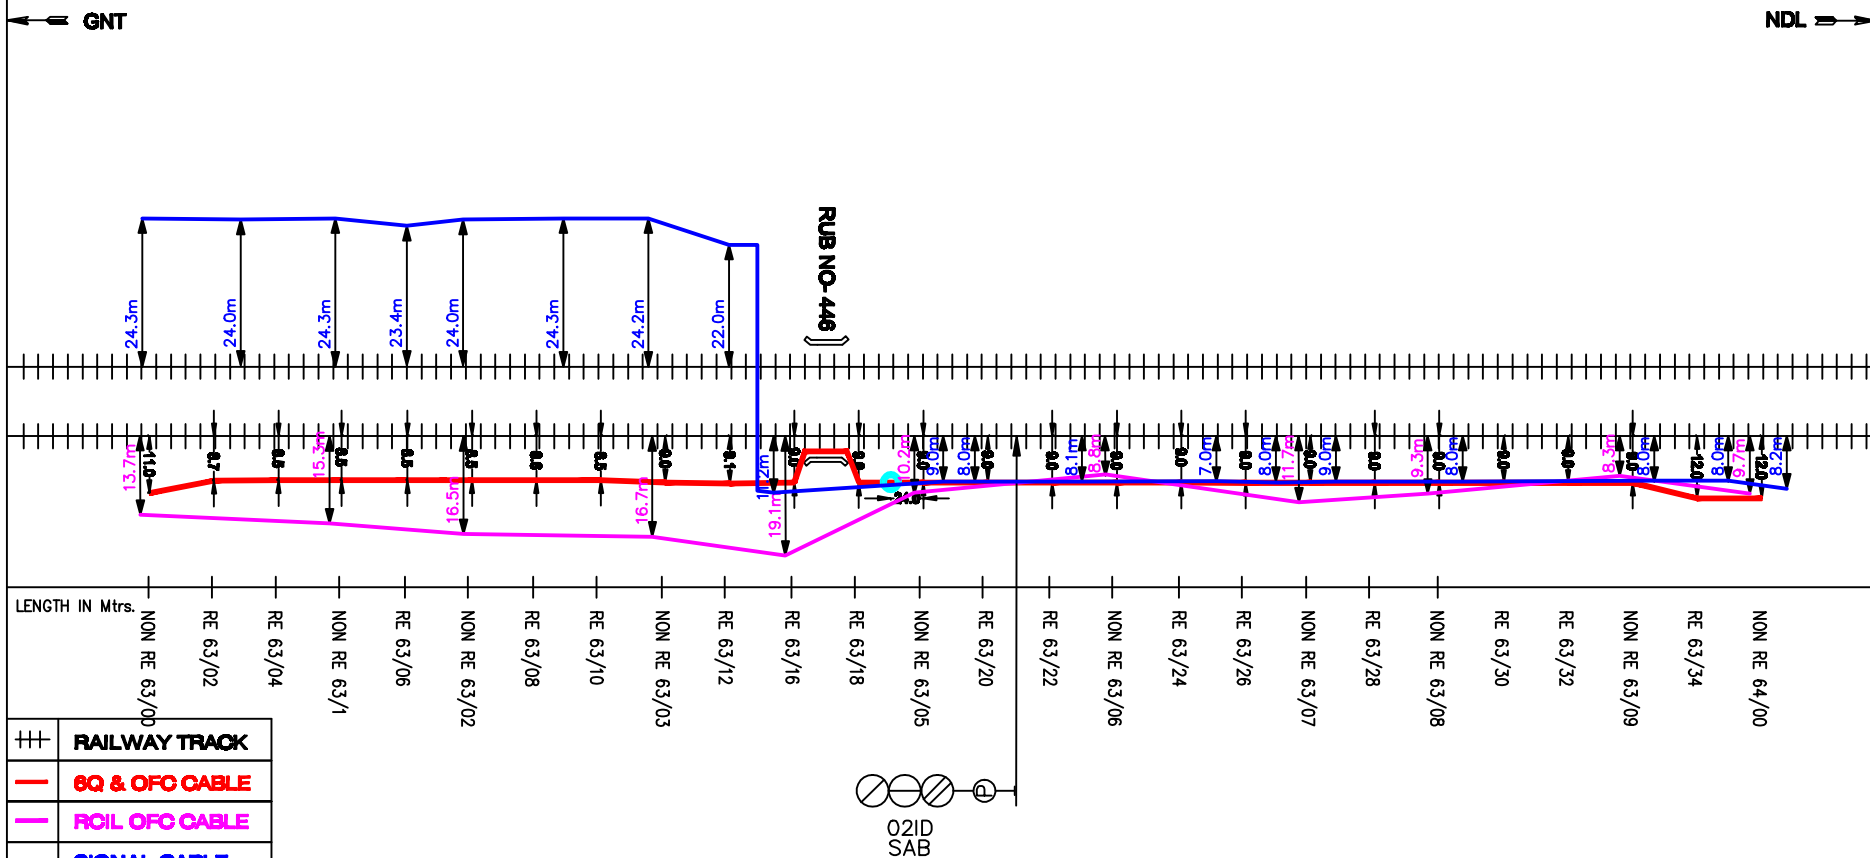

LENGTH IN Mtrs.	NON RE 63/00	RE 63/02	RE 63/04	NON RE 63/06	RE 63/06	NON RE 63/02	RE 63/08	RE 63/10	NON RE 63/03	RE 63/12	RE 63/16	RE 63/18	NON RE 63/05	RE 63/20	RE 63/22	NON RE 63/06	RE 63/24	RE 63/26	NON RE 63/07	RE 63/28	NON RE 63/08	RE 63/30	RE 63/32	NON RE 63/09	RE 63/34	NON RE 64/00
RAILWAY TRACK	++																									
6Q & OFC CABLE	—																									
ROIL OFC CABLE	—																									
SIGNAL CABLE	—																									
NORMAL/DERIVATION JOINT	□																									
BRIDGE/CULVERT	⌋⌋																									
EO POST	⊕																									
L.O.GATE	⌈⌋																									

NDL 

SANTHAMAGULUR-SAVALYAPURAM Jn. **6 QUAD, OFC & SIGNAL CABLE PATH**

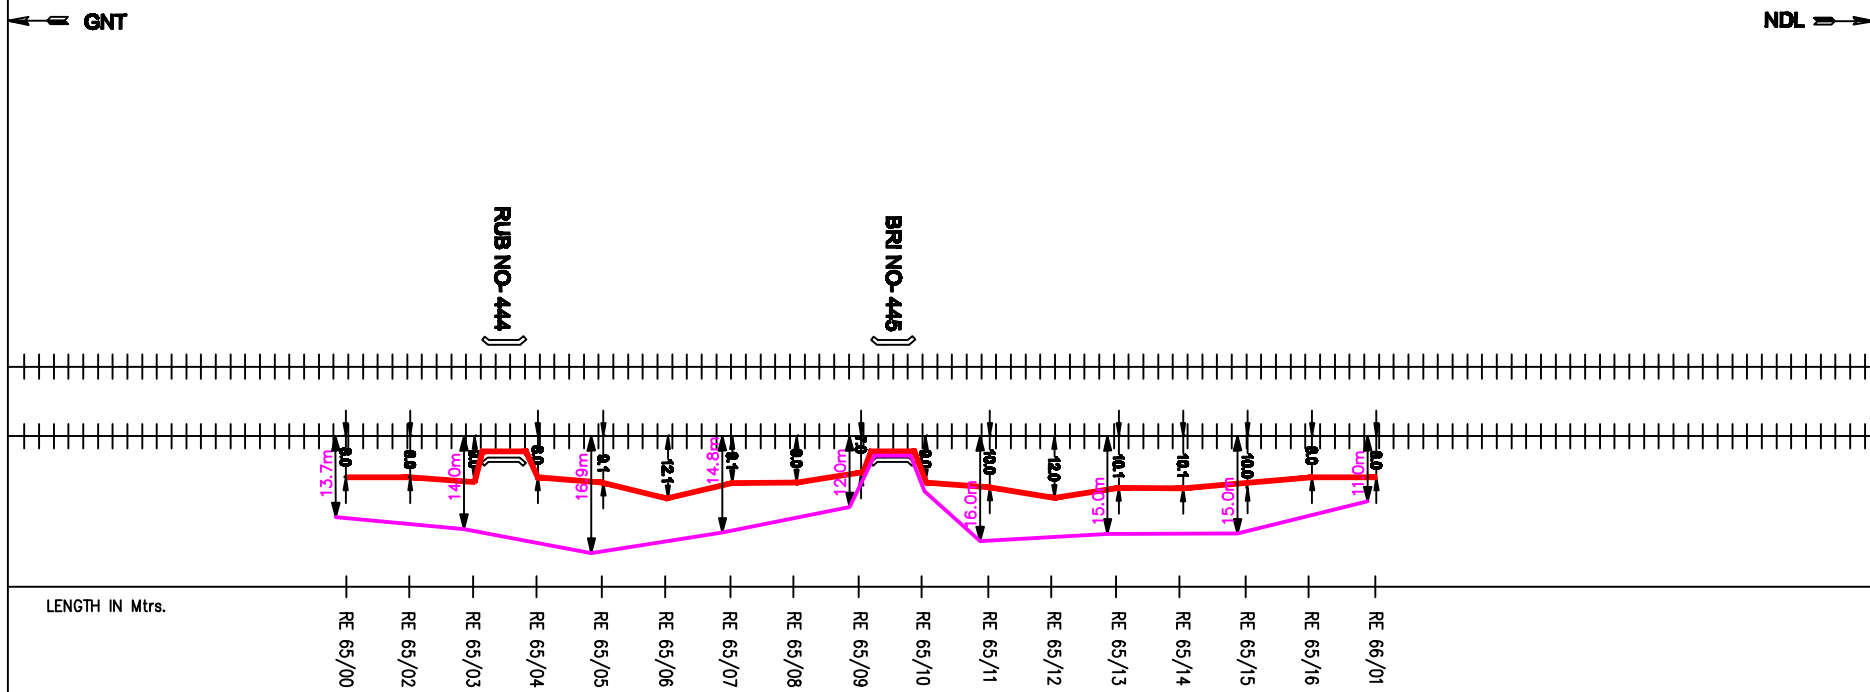

LENGTH IN Mtrs.

++	RAILWAY TRACK
—	6Q & OFC CABLE
—	ROIL OFC CABLE
—	SIGNAL CABLE
□	NORMAL/ DERIVATION JOINT
⌋⌋	BRIDGE/CULVERT
⊕	EO POST
⌋⌋	L.O.GATE

SHEET 5 OF 12

SAB - SYM SECTION


SANTHAMAGULUR-SAVALYAPURAM Jn. **6 QUAD, OFC & SIGNAL CABLE PATH**

GNT ←

NDL →

RUB NO-444

BRI NO-444

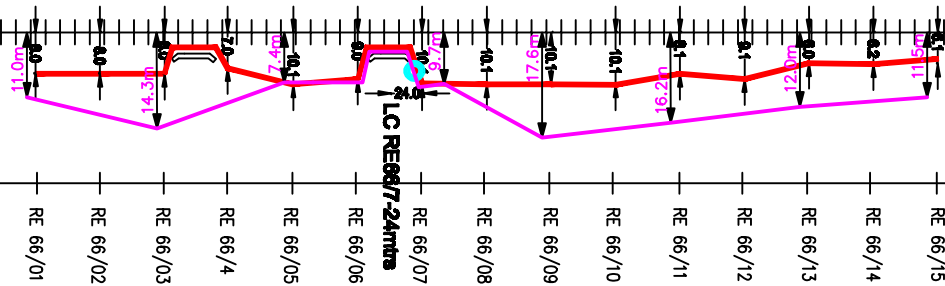

LENGTH IN Mtrs.

++	RAILWAY TRACK
—	6Q & OFC CABLE
—	ROIL OFC CABLE
—	SIGNAL CABLE
□	NORMAL/ DERIVATION JOINT
⌋⌋	BRIDGE/CULVERT
⊕	EC POST
⌋⌋	L.C.GATE


SHEET 6 OF 12

SAB - SYM SECTION

SANTHAMAGULUR-SAVALYAPURAM Jn. **6 QUAD, OFC & SIGNAL CABLE PATH**

← GNT

NDL →

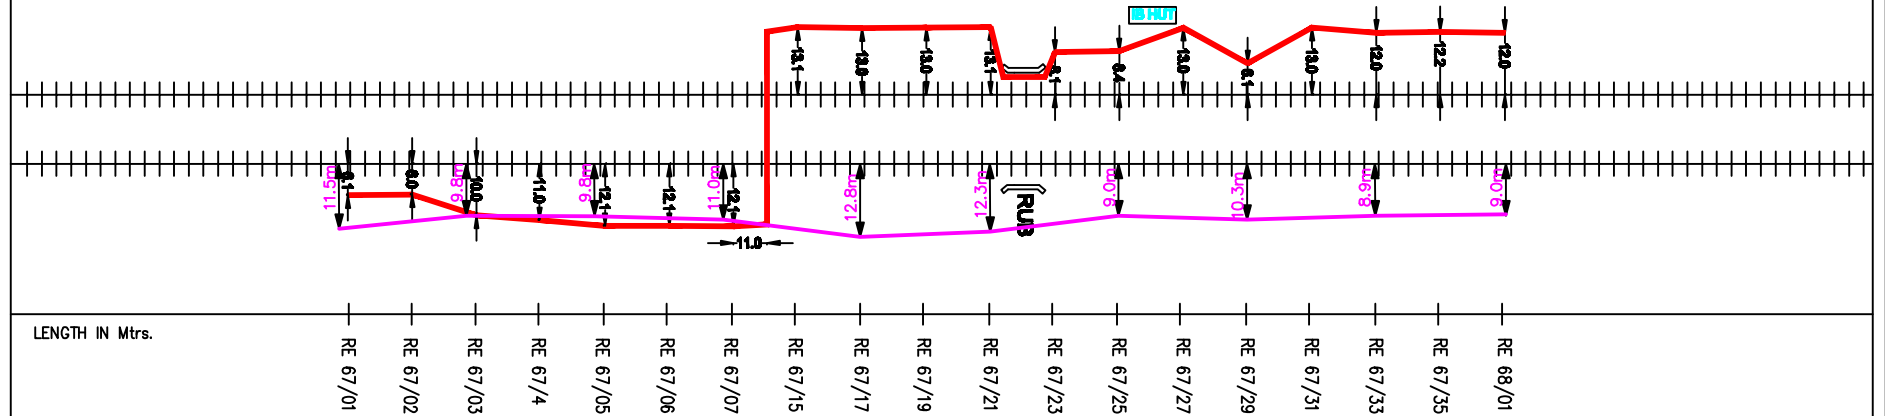


LENGTH IN Mtrs.

++	RAILWAY TRACK
—	6Q & OFC CABLE
—	POIL OFC CABLE
—	SIGNAL CABLE
□	NORMAL/ DERIVATION JOINT
⌋⌋	BRIDGE/CULVERT
⊕	EO POST
⌋⌋	LO GATE

SHEET 7 OF 12


SAB - SYM SECTION

SANTHAMAGULUR-SAVALYAPURAM Jn. **6 QUAD, OFC & SIGNAL CABLE PATH**

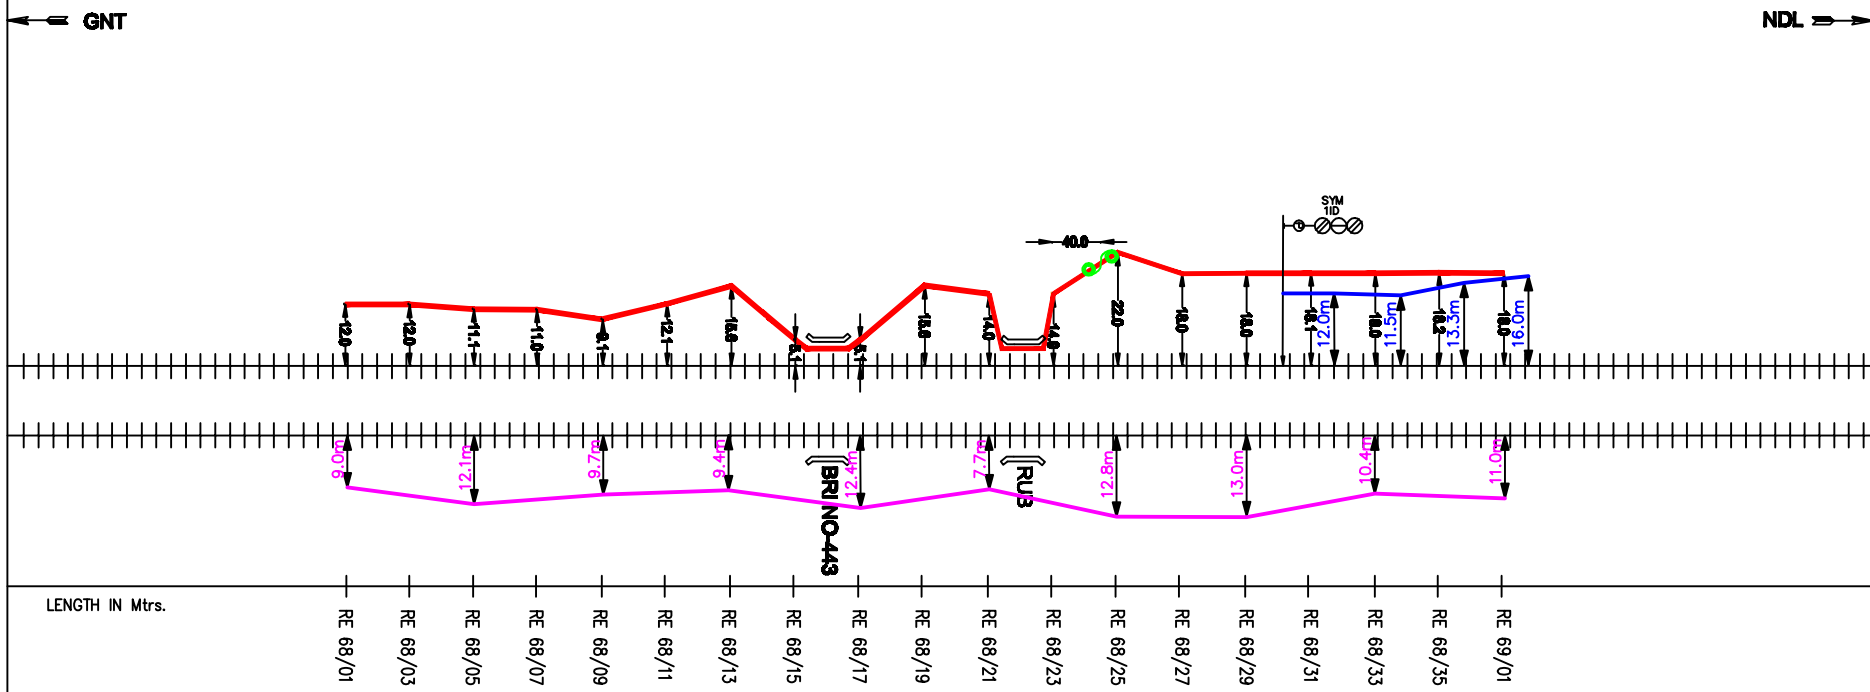

++	RAILWAY TRACK
—	6Q & OFC CABLE
—	ROIL OFC CABLE
—	SIGNAL CABLE
□	NORMAL/DERIVATION JOINT
⌋⌋	BRIDGE/CULVERT
⊕	EO POST
⌋⌋	L.O.GATE

SANTHAMAGULUR-SAVALYAPURAM Jn. **6 QUAD, OFC & SIGNAL CABLE PATH**

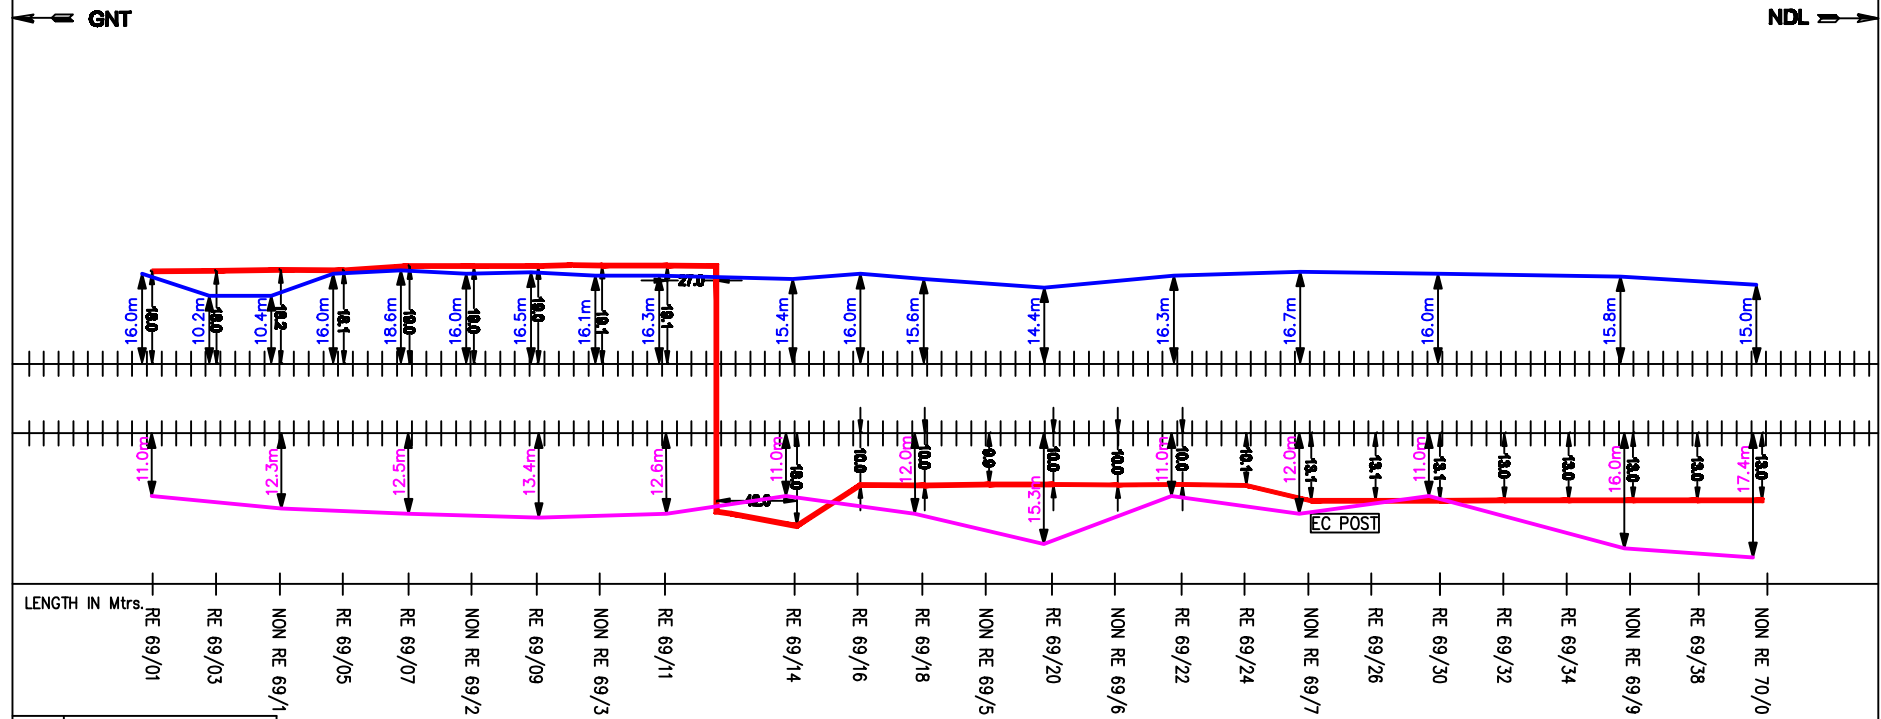

⚡	RAILWAY TRACK
—	6Q & OFO CABLE
—	POIL OFO CABLE
—	SIGNAL CABLE
□	NORMAL/DERIVATION JOINT
⌋	BRIDGE/CULVERT
⊕	EC POST
⚡	L.O.GATE


SHEET 9 OF 12

SAB - SYM SECTION

SANTHAMAGULUR-SAVALYAPURAM Jn. **6 QUAD, OFC & SIGNAL CABLE PATH**

GNT ←

NDL →

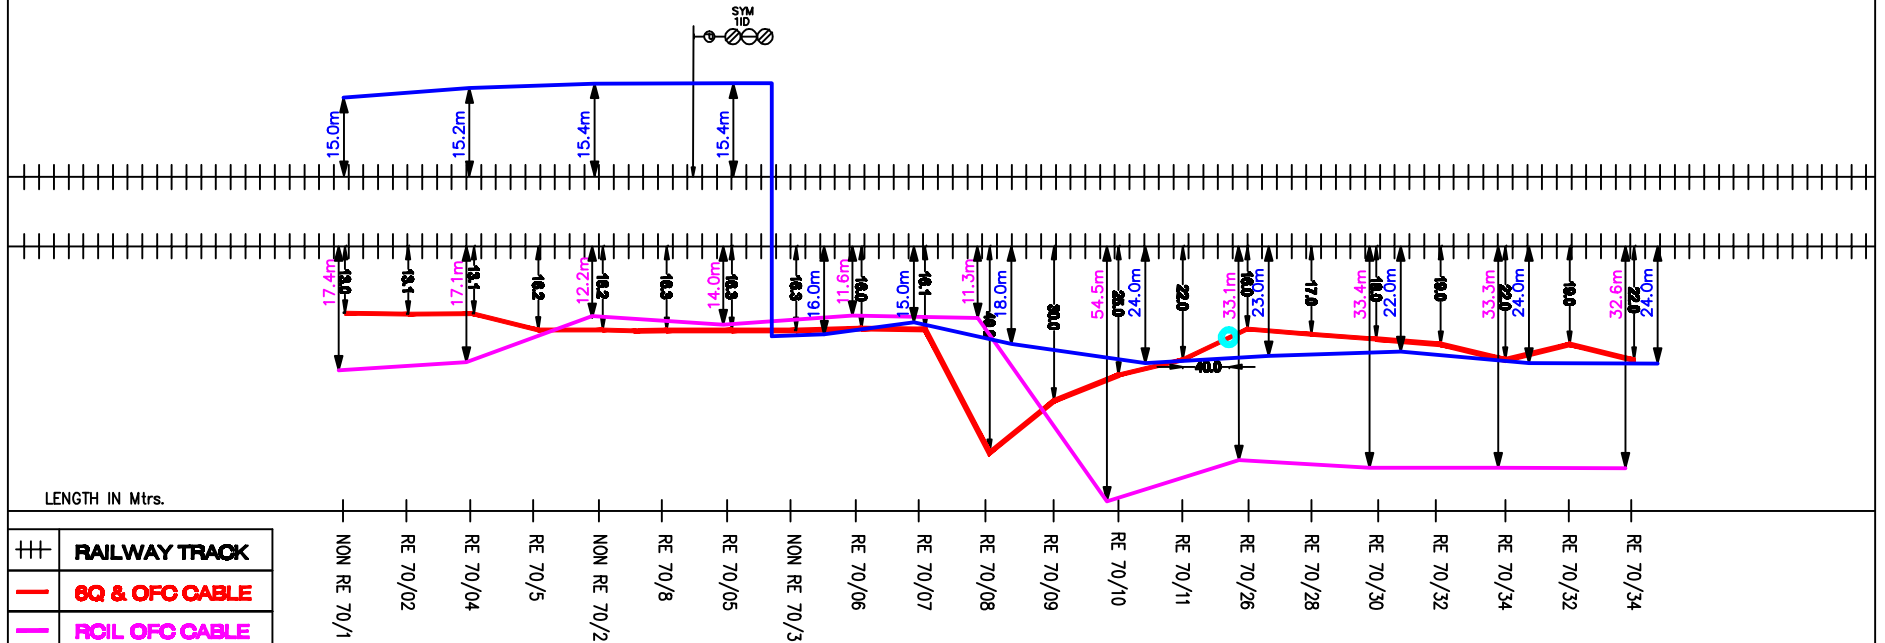

LENGTH IN Mtrs.

+	RAILWAY TRACK
—	6Q & OFC CABLE
—	FOIL OFC CABLE
—	SIGNAL CABLE
□	NORMAL/ DERIVATION JOINT
))	BRIDGE/CULVERT
⊕	EO POST
⊕	L.O.GATE

SHEET 10 OF 12

SAB - SYM SECTION

SANTHAMAGULUR-SAVALYAPURAM Jn.

6 QUAD, OFC & SIGNAL CABLE PATH

← GNT
NDL →

SYM →

BRI NO-441


LENGTH IN Mtrs.

++	RAILWAY TRACK
—	OFC & OFC CABLE
—	OFC CABLE
—	SIGNAL CABLE
□	NORMAL/DERIVATION JOINT
⌋	BRIDGE/CULVERT
⊕	EO POST
⌋	L.O. GATE

SAB - SYM SECTION
SHEET 11 OF 12

SAB - SYM SECTION

SANTHAMAGULUR-SAVALYAPURAM Jn. **6 QUAD, OFC & SIGNAL CABLE PATH**

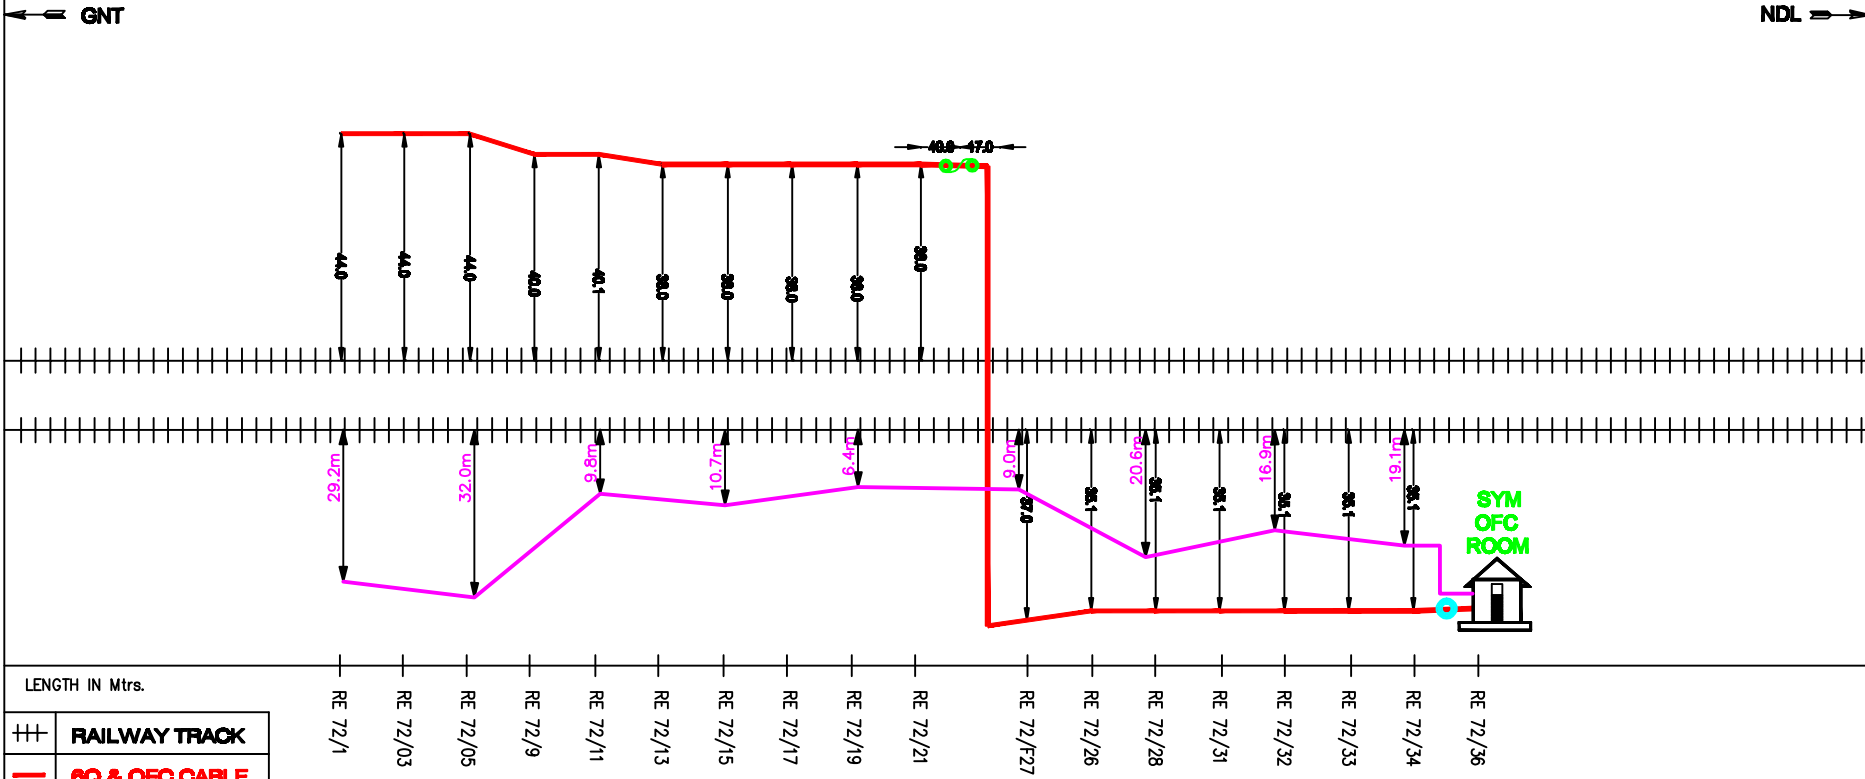

LENGTH IN Mtrs.	
+	RAILWAY TRACK
—	OFC & SIGNAL CABLE
—	RCIL OFC CABLE
—	SIGNAL CABLE
□	NORMAL/DERIVATION JOINT
⌋	BRIDGE/CULVERT
⊕	EO POST
⌋	L.C.GATE

SHEET 12 OF 12

SAB - SYM SECTION						
ALT No.	MANAGESWARA RAO NARO SSE/D	AGM/RCIL	MSUBRAMANYAM SSE/S/MKN	S.VENKATESWARULLU SSE/T/MKN	D.BARATH BABU ADSTE/GNT	S.LALAKSHMAN Sr.DSTE/GNT